

PIKE
M 41
11-5-69

MISSISSIPPI
BOARD OF WATER COMMISSIONERS
416 North State Street
Jackson, Mississippi 39201

CODED

WATER WELL DRILLERS LOG

11-5
date well completed

1969 *Fitzgerald well*
firm name

Pike
county well located

LANDOWNER:

Eddie Calmon

R.R., Magnolia, Miss.
(mailing address)

WELL LOCATION:

sec. 20 T 1 N R 9 E
1 miles S of *Progress*
(distance) (direction) (nearest town)

WELL PURPOSE: *Home*
(home, irrigation, municipal, industrial)

WELL COMPLETION DATA:

- (1) diameter (inches) 4
- (2) total depth (feet) 106
- (3) static water level (feet) 85 below above top of ground.
- (4) casing Plastic, 100,
(material) (depth)
4 if telescope see back.
(size)
- (5) screen 6, 100
(length) (depth to top)
4, Plastic
(size) (material)
- (6) pump ?, ?
(HP) (yield gpm)
?
(type power)
- (7) electric log no
(yes or no)
(organization running log)
- (8) how well bottom plugged reworked

description of formations encountered

from to

| | | |
|---------------------------------|------------|------------|
| <i>Red clay</i> | <i>6</i> | <i>20</i> |
| <i>Red sand</i> | <i>20</i> | <i>60</i> |
| <i>Red sand & gravel</i> | <i>60</i> | <i>90</i> |
| <i>Coarse sand</i> | <i>90</i> | <i>100</i> |
| <i>Coarse sand & gravel</i> | <i>100</i> | <i>100</i> |

CODED


DRILLERS REMARKS:

NOV 21 1969

MISS. DE. OF
WATER COMMISSIONERS

If well telescopes please sketch and show depths.

GROUND LEVEL

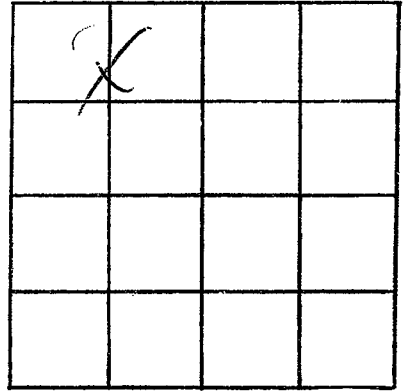

SECTION 20

Please indicate well location X.

ADDITIONAL INFORMATION

If more than one screen,
show locations of each on sketch.