

PIKE

M42

3-26-71

MISSISSIPPI BOARD OF WATER COMMISSIONERS  
416 North State Street  
Jackson, Mississippi 39201

**CODED**

WATER WELL DRILLERS LOG

March 26 1971 date well completed  
Chester Keener firm name  
Pike county well located

LANDOWNER: Bobby  
Schilling  
P.O. Box  
(mailing address)

description of formations encountered

from to

red clay 0 18  
red sand gravel 18 78  
chalky sand 78 132  
smaller gravel 132 148

WELL LOCATION:

sec 34 T 1 N R 9 E  
3 miles SE of Prager  
(distance) (direction) (nearest town)

WELL PURPOSE: domestic  
(home, irrigation, municipal, industrial)

WELL COMPLETION DATA:

- (1) diameter (inches) 4"
- (2) total depth (feet) 148
- (3) static water level (feet) 78 below top of ground
- (4) casing (material) (depth) Plast. Bottom
- (size) if telescope see back.
- (5) screen (length) (depth to top) 10' 138'
- (size) (material) 4" Plast
- (6) pump (HP) (yield gpm) 20
- (type power) plst.
- (7) electric log (yes or no) No

**CODED**

(organization running log)

(8) how well bottom plugged wooden plug


MAY 20 1971

DRILLERS REMARKS: all well  
insufficient

MISS. BD. OF  
WATER COMM.

If well telescopes please sketch and show depths.

GROUND LEVEL

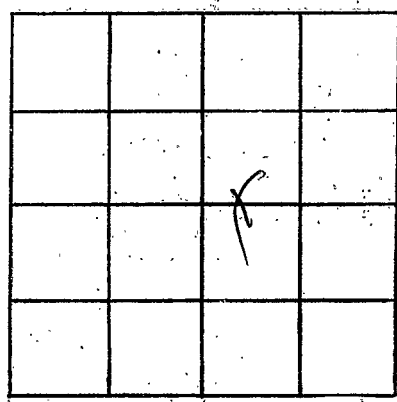

SECTION 34

Please indicate well location X.

ADDITIONAL INFORMATION

If more than one screen, show locations of each on sketch.