

PIKE  
M43  
5-19-71

MISSISSIPPI  
BOARD OF WATER COMMISSIONERS  
416 North State Street  
Jackson, Mississippi 39201

**CODED**

WATER WELL DRILLERS LOG

5-19 1971 Fitzgerald Well Serv Pike  
date well completed firm name county well located

LANDOWNER:  
T.R. Quinn  
B.B. Osburn (mailing address)

description of formations encountered	from	to
<u>Red clay</u>	<u>0</u>	<u>20</u>
<u>Red sand</u>	<u>20</u>	<u>40</u>
<u>Coarse sand</u>	<u>40</u>	<u>67</u>

WELL LOCATION:  
sec. 31 T 1N R 9E  
9 miles E of Osburn  
(distance) (direction) (nearest town)

WELL PURPOSE: Home  
(home, irrigation, municipal, industrial)

- WELL COMPLETION DATA:
- (1) diameter (inches) 4
  - (2) total depth (feet) 67
  - (3) static water level (feet) 35 below above top of ground.
  - (4) casing Alustic 59  
(material) (depth)  
4 if telescope see back.  
(size)
  - (5) screen 8 59  
(length) (depth to top)  
4 Alustic  
(size) (material)
  - (6) pump 1/2 12  
(HP) (yield gpm)  
Elco  
(type power)
  - (7) electric log no  
(yes or no)  
(organization running log)
  - (8) how well bottom plugged woodpe


**CODED**

JUN 14 1971

DRILLERS REMARKS:

If well telescopes please sketch and show depths.

GROUND LEVEL

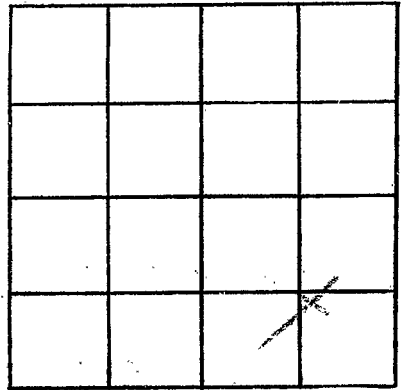

SECTION 37

Please indicate well location X.

ADDITIONAL INFORMATION

If more than one screen,  
show locations of each on sketch.