

PIKE
M 44
6-10-71

MISSISSIPPI
BOARD OF WATER COMMISSIONERS
416 North State Street
Jackson, Mississippi 39201

CODED

WATER WELL DRILLERS LOG

6-10 1971 *St. James Well Co. Pike*
date well completed firm name county well located

LANDOWNER:	description of formations encountered	from	to
<i>Salmon Fuller</i>			
<i>P.B. Magnolia</i> (mailing address)	<i>Red clay</i>	<i>6</i>	<i>20</i>
	<i>Red sand</i>	<i>20</i>	<i>65</i>
	<i>Red sand</i>	<i>65</i>	<i>90</i>
WELL LOCATION:	<i>Coarse sand & gravel</i>	<i>90</i>	<i>106</i>
sec. <i>14</i> T. <i>1</i> N. R. <i>9</i> E			
<i>6</i> miles <i>SW</i> of <i>Dyers Crossing</i>			
(distance) (direction) of (nearest town)			
WELL PURPOSE: (home, irrigation, municipal, industrial)			
<i>Home</i>			
WELL COMPLETION DATA:			
(1) diameter (inches) <i>4</i>			
(2) total depth (feet) <i>106</i>			
(3) static water level (feet) <i>65</i> below top of ground.			
(4) casing <i>Plastic</i> <i>98</i> (material) (depth)			
<i>4</i> if telescope see back. (size)			
(5) screen <i>8</i> <i>98</i> (length) (depth to top)			
<i>4</i> <i>Plastic</i> (size) (material)			
(6) pump <i>3/4</i> <i>5</i> (HP) (yield gpm)			
<i>Electric</i> (type power)			
(7) electric log <i>yes</i> (yes or no)			
(organization running log)			
(8) how well bottom plugged <i>completely</i>			
DRILLERS REMARKS:			


CODED

JUN 1 1971

MISS. BD. OF
WATER COMMISSIONERS

If well telescopes please sketch and show depths.

GROUND LEVEL

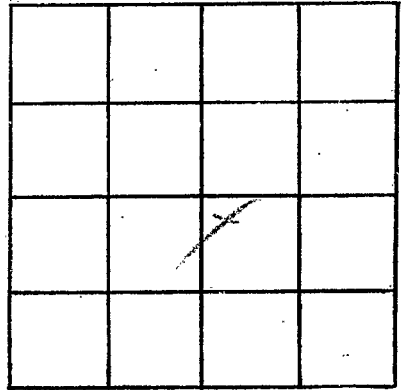

SECTION of

Please indicate well location X.

ADDITIONAL INFORMATION

If more than one screen, show locations of each on sketch.