

Pike
M 46
6-10-71

MISSISSIPPI
BOARD OF WATER COMMISSIONERS
416 North State Street
Jackson, Mississippi 39201

WATER WELL DRILLERS LOG

CODED


June 10 19 71 date well completed
Chester Keen firm name
county well located

LANDOWNER	description of formations encountered	from	to
Mrs. Mamie Schilling Rt-1, Ogden (mailing address)	Red clay Red sand gravel Gravel & sand	0 27 92	27 92 110
WELL LOCATION: sec 28 T 1 N R 9 E 3 miles SE Poplar (distance) (direction) (nearest town)			
WELL PURPOSE: Home (home, irrigation, municipal, industrial)			
WELL COMPLETION DATA:			
(1) diameter (inches) 4"			
(2) total depth (feet) 110			
(3) static water level (feet) 80 below top of ground. above			
(4) casing <u>Plast Ballast</u> (material) (depth)			
(size) If telescope see back.			
(5) screen 6' 104 (length) (depth to top)			
4" <u>Plast</u> (size) (material)			
(6) pump <u>Hydraulic</u> (HP) (yield gpm)			
(type power)			
(7) electric log <u>NO</u> (yes or no)			
(organization running log)			
(8) how well bottom plugged <u>wooden plug</u>			
DRILLERS REMARKS: <u>old well had</u>			

CODED

If well telescopes please sketch and show depths.

GROUND LEVEL

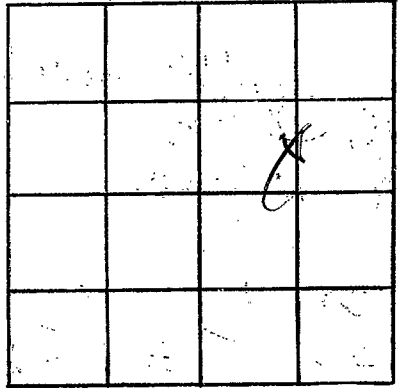

SECTION 28

Please indicate well location X.

ADDITIONAL INFORMATION

If more than one screen, show locations of each on sketch.