

Pike
M 48
11-24-71

MISSISSIPPI
BOARD OF WATER COMMISSIONERS
416 North State Street
Jackson, Mississippi 39201

DEC 28 1971

CODED

WATER WELL DRILLERS LOG


11-24 date well completed 19 71 firm name Pike county well located

LANDOWNER:	description of formations encountered	from	to
Salem Simmons P.O. 2 m. Comb. Min. (mailing address)			
WELL LOCATION: sec. 11 T. 1 N. R. 9 E 12 miles E of Magnolia (distance) (direction) (nearest town)			
WELL PURPOSE: (home, irrigation, municipal, industrial)			
WELL COMPLETION DATA:			
(1) diameter (inches) 4			
(2) total depth (feet) 123			
(3) static water level (feet) 80 below top of ground.			
(4) casing plastic, 115 (material) (depth) 4 (size) if telescope see back.			
(5) screen 8 (length), 115 (depth to top) 4 (size), plastic (material)			
(6) pump 1 (HP), 7 (yield gpm) ell (type power)			
(7) electric log No (yes or no) (organization running log)			
(8) how well bottom plugged good			
DRILLERS REMARKS:			

CODED

If well telescopes please sketch and show depths.

GROUND LEVEL

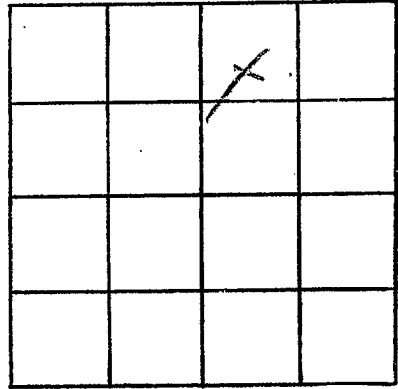

SECTION 11

Please indicate well location X.

ADDITIONAL INFORMATION

If more than one screen,
show locations of each on sketch.