

Pike  
M 49  
12-29-71

MISSISSIPPI  
BOARD OF WATER COMMISSIONERS  
416 North State Street  
Jackson, Mississippi 39201

WATER WELL DRILLERS LOG

CODED

Dec 29 1971 Chestokernes Pike  
date well completed firm name county well located

LANDOWNER: Claude D  
Magel -  
Rt 4, Magnolia -  
(mailing address)

description of formations encountered	from	to
Red clay	0	18
Red sand	18	62
Small gravel sand with clay	62	90
Small gravel	90	103

WELL LOCATION:

sec. 4 T 1 N R 9 E  
0.2 miles NE of Puka  
(distance) (direction) (nearest town)

WELL PURPOSE: Home  
(home, irrigation, municipal, industrial)

WELL COMPLETION DATA:

- (1) diameter (inches) 4"
- (2) total depth (feet) 103
- (3) static water level (feet) 51 below top of ground
- (4) casing Plast. bottom  
(material) (depth)
- (size) if telescope see back.
- (5) screen 6' 97  
(length) (depth to top)
- 4" Plast.  
(size) (material)
- (6) pump 1/2 Sub 15  
(HP) (yield gpm)
- 5.5 kw  
(type power)
- (7) electric log no  
(yes or no)

CODED

(organization running log)

(8) how well bottom plugged  
wooden plug


DRILLERS REMARKS:  
all 2" well bad.

JAN 21 1972

MISS. BD. OF  
WATER COMMS.

If well telescopes please sketch and show depths.

GROUND LEVEL

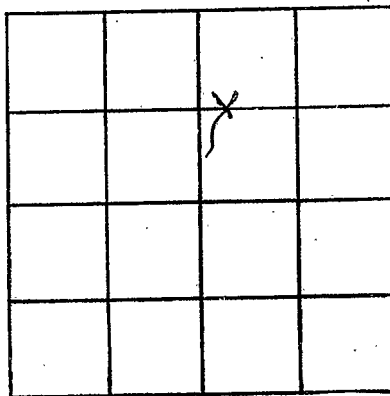

SECTION 4

Please indicate well location X.

ADDITIONAL INFORMATION

If more than one screen, show locations of each on sketch.