

MISSISSIPPI
BOARD OF WATER COMMISSIONERS
416 North State Street
Jackson, Mississippi 39201

CODED

WATER WELL DRILLERS LOG

Pike
M 50
4-21-72

April 21 1972 Chesters Pike
date well completed firm name county well located

LANDOWNER: Flowers, Sheri

description of formations encountered

H-1, seyka -
(mailing address)

	from	to
<u>Red clay</u>	<u>0</u>	<u>17</u>
<u>Red sand</u>	<u>17</u>	<u>60</u>
<u>sand & gravel</u>	<u>60</u>	<u>78</u>
<u>chalky sand & gravel</u>	<u>78</u>	<u>119</u>
<u>gravel & sand</u>	<u>119</u>	<u>126</u>

WELL LOCATION:

sec. 18 T. 1 N. R. 9 E.
1 miles W of Prayers
(distance) (direction) (nearest town)

WELL PURPOSE: Home
(home, irrigation, municipal, industrial)

WELL COMPLETION DATA:

- (1) diameter (inches) 4"
- (2) total depth (feet) 126
- (3) static water level (feet) 6' below top of ground.
- (4) casing Plast. bottom
(material) (depth)
- _____ if telescope see back.
(size)
- (5) screen 6' 120'
(length) (depth to top)
- 4" Plast.
(size) (material)
- (6) pump h. sub 1 1/2
(HP) (yield gpm)
- elect
(type power)
- (7) electric log NO
(yes or no)
- _____ (organization running log)

CODED


(8) how well bottom plugged water plug

DRILLERS REMARKS: new house.

JUL 20 1972
MISS. SD. 05
WATER CONTROL

If well telescopes please sketch and show depths.

GROUND LEVEL

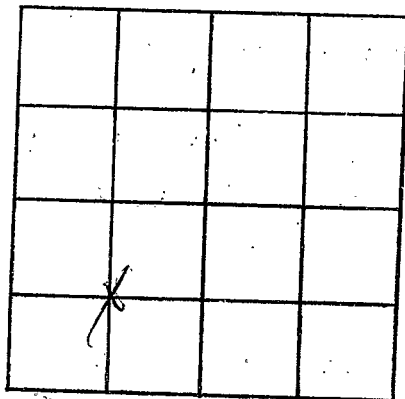

SECTION 18

Please indicate well location X.

ADDITIONAL INFORMATION

If more than one screen,
show locations of each on sketch.