

Pike
M 51
6-12-72

MISSISSIPPI
BOARD OF WATER COMMISSIONERS
416 North State Street
Jackson, Mississippi 39201

CODED

WATER WELL DRILLERS LOG

6-12-72 date well completed 1972 F. L. ... firm name Pike county well located

LANDOWNER:
J. D. Easley
R.R. Magnolia Miss.
(mailing address)

description of formations encountered	from	to
Red Clay	0	20
Red Limestone	20	148
Coarse sand & gravel	148	162

WELL LOCATION:
sec. 20 T-1 N R-9 E
1/4 miles SE of Prager
(distance) (direction) (nearest town)

WELL PURPOSE: Home
(home, irrigation, municipal, industrial)

- WELL COMPLETION DATA:
- (1) diameter (inches) 4
 - (2) total depth (feet) 162
 - (3) static water level (feet) 90 below top of ground.
 - (4) casing Plastic 154 (material) (depth)
4 (size) if telescope see back.
 - (5) screen 8 154 (length) (depth to top)
4 (size) Plastic (material)
 - (6) pump 3/4 15 (HP) (yield gpm)
Elec (type power)
 - (7) electric log yes (yes or no)
(organization running log)
 - (8) how well bottom plugged 6" gravel

CODED


JUL 24 1972

MISS. Bd. OF
WATER COMMISSIONERS

DRILLERS REMARKS:

If well telescopes please sketch and show depths.

GROUND LEVEL

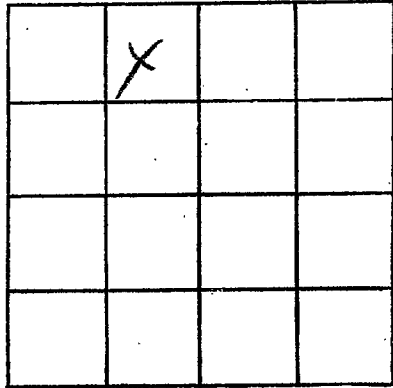

SECTION 20

Please indicate well location X.

ADDITIONAL INFORMATION

If more than one screen,
show locations of each on sketch.