




If well telescopes please sketch and show depths.

GROUND LEVEL

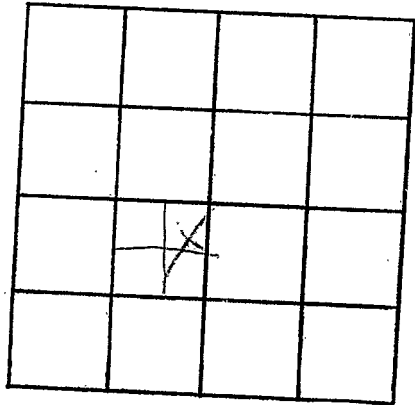

SECTION         

Please indicate well location X.

ADDITIONAL INFORMATION

Lined area for additional information.

If more than one screen, show locations of each on sketch.