

Pike
M57
7-10-72

MISSISSIPPI
BOARD OF WATER COMMISSIONERS
416 North State Street
Jackson, Mississippi 39201

WATER WELL DRILLERS LOG

July 10 1972 Chester Beemer Pike
date well completed firm name county well located

LANDOWNER: Ledger Smith
RFD - Tiptonville
(mailing address)

WELL LOCATION:
sec. 11 T. 1 N R. 9 E
4 miles ENE of Prosser
(distance) (direction) (nearest town)

WELL PURPOSE: Home
(home, irrigation, municipal, industrial)

WELL COMPLETION DATA:

- (1) diameter (inches) 4"
- (2) total depth (feet) 132
- (3) static water level (feet) 90 above top of ground.
- (4) casing plastic ballast
(material) (depth)
- _____ If telescope see back.
(size)
- (5) screen 6" 176'
(length) (depth to top)
- 4" plastic
(size) (material)
- (6) pump 1/2 sub 12
(HP) (yield gpm)
- elec.
(type power)
- (7) electric log NO
(yes or no)

_____ (organization running log)

(8) how well bottom plugged wooden plug


description of formations encountered	from	to
red clay	0	17
Red Sand	17	76
Sand & gravel	76	93
white chalk	93	114
coarse sand & peagranul	114	132

REMARKS:

DEC. 1 1972

If well telescopes please sketch and show depths.

GROUND LEVEL

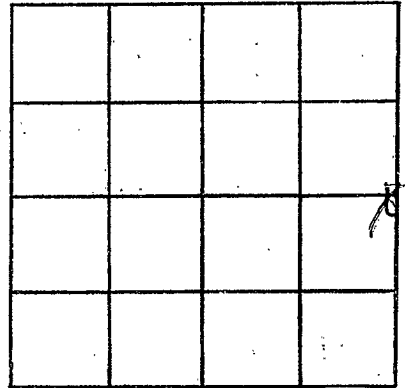

SECTION 11

Please indicate well location X.

ADDITIONAL INFORMATION

If more than one screen,
show locations of each on sketch.