

Pike
M 58
10-5-72

MISSISSIPPI
BOARD OF WATER COMMISSIONERS
416 North State Street
Jackson, Mississippi 39201

CODED

WATER WELL DRILLERS LOG

Oct 5 1972 Chester Keener Pike
date well completed firm name county well located

LANDOWNER: J. H. Lamb

description of formations encountered

RT 4, Magnolia
(mailing address)

description of formations encountered	from	to
red clay	0	19
Sand & gravel	19	53
chalk	53	70
Sand	70	109
Sand & gravel	109	117

WELL LOCATION:
sec. 18 T 1 N R 9 E
in Progress
(distance) (direction) (nearest town)

WELL PURPOSE: house stone
(home, irrigation, municipal, industrial)

WELL COMPLETION DATA:

(1) diameter (inches) 4 1/2"

(2) total depth (feet) 117

(3) static water level (feet) 87 below above top of ground.

(4) casing plast. ballast
(material) (depth)

_____ if telescope see back.
(size)

(5) screen 6' 111'
(length) (depth to top)

1/2" plast.
(size) (material)

(6) pump Byoung
(HP) (yield gpm)

(type power)

(7) electric log no
(yes or no)

(organization running log)

(8) how well bottom plugged wooden plug


CODED

DEC 4 1972

DRILLERS REMARKS:

If well telescopes please sketch and show depths.

GROUND LEVEL

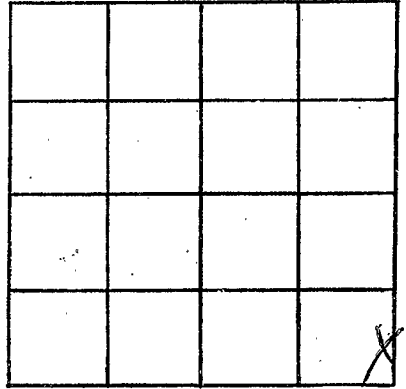

SECTION 18

Please indicate well location X.

ADDITIONAL INFORMATION

If more than one screen, show locations of each on sketch.