

Pike
M 59
11-16-72

MISSISSIPPI
BOARD OF WATER COMMISSIONERS
416 North State Street
Jackson, Mississippi 39201

WATER WELL DRILLERS LOG

CODED

11-16-1972 date well completed
Fulginiti & Sons firm name
Pike county well located

LANDOWNER:
Shady Grove Church -
R.R. Osyka, Mrs.
(mailing address)

WELL LOCATION:
sec. 29 T. 1 N R. 9 E
8 miles S of Piquem
(distance) (direction) (nearest town)

WELL PURPOSE:
Home
(home, irrigation, municipal, industrial)

- WELL COMPLETION DATA:
- (1) diameter (inches) 4
 - (2) total depth (feet) 163
 - (3) static water level (feet) 80 below above top of ground.
 - (4) casing Plastic 155
(material) (depth)
4 if telescope see back.
(size)
 - (5) screen 8, 155
(length) (depth to top)
4, Plastic
(size) (material)
 - (6) pump 1/2 10
(HP) (yield gpm)
elec
(type power)
 - (7) electric log no
(yes or no)
(organization running log)
 - (8) how well bottom plugged covered

description of formations encountered	from	to
Red Clay	0	20
Red Sand	20	90
Red gravel	90	120
Red sand	100	145
Coarse red gravel	145	163

CODED


DRILLERS REMARKS:

DEC 7 1972

MISSISSIPPI
WATER COMMISSIONERS

If well telescopes please sketch and show depths.

GROUND LEVEL

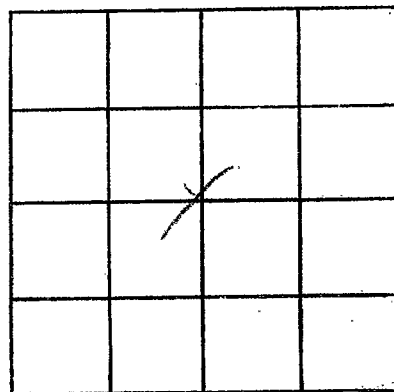

SECTION 29

Please indicate well location X.

ADDITIONAL INFORMATION

If more than one screen,
show locations of each on sketch.