

Pike
M 60.
11-3-72

MISSISSIPPI
BOARD OF WATER COMMISSIONERS
416 North State Street
Jackson, Mississippi 39201

CODED

WATER WELL DRILLERS LOG

NOV. 3 1972
date well completed

chester keener
firm name

Pike
county well located

LANDOWNER: Norman

description of formations encountered

from

to

Schilling -

sandy clay
red sand
coarse sand

8 21
21 74
74 94

P.O. Mahan
(mailing address)

WELL LOCATION:

sec. 21 T 1 N R 9 E
1 1/2 miles SE of Poplar
(distance) (direction) (nearest town)

WELL PURPOSE: home
(home, irrigation, municipal, industrial)

WELL COMPLETION DATA:

- (1) diameter (inches) 4"
- (2) total depth (feet) 94
- (3) static water level (feet) 73 below top of ground.
- (4) casing Plastic bottom
(material) (depth)
- (size) if telescope see back.
- (5) screen 6' 88'
(length) (depth to top)
- 4" Plast
(size) (material)
- (6) pump 1/2 HP 15
(HP) (yield gpm)
- 220
(type power)
- (7) electric log NO
(yes or no)

(organization running log)

(8) how well bottom plugged

wooden plug

DRILLERS REMARKS:

New Home


CODED

MAR 29 1973

WATER BOARD

If well telescopes please sketch and show depths.

GROUND LEVEL

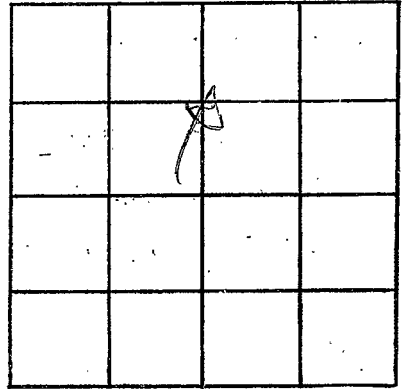

SECTION 21

Please indicate well location X.

ADDITIONAL INFORMATION

If more than one screen,
show locations of each on sketch.