

PRICE
M 61
9-4-73

MISSISSIPPI
 BOARD OF WATER COMMISSIONERS
 416 North State Street
 Jackson, Mississippi 39201

CODED

WATER WELL DRILLERS LOG

9-4 1973 Fitzgerald Inc Price
 date well completed firm name county well located


LANDOWNER:	description of formations encountered	from	to
<u>James Hickey</u> <u>R.R. Oyster</u> (mailing address)	<u>Red clay</u> <u>Coarse sand & gravel</u>	<u>6</u> <u>20</u>	<u>20</u> <u>22</u>
WELL LOCATION: sec. <u>33</u> T. <u>10</u> S. R. <u>9</u> E. <u>11</u> miles <u>E</u> of <u>OSKA</u> (distance) (direction) (nearest town)			
WELL PURPOSE: <u>Home</u> (home, irrigation, municipal, industrial)			
WELL COMPLETION DATA:			
(1) diameter (inches) <u>4</u>			
(2) total depth (feet) <u>72</u>			
(3) static water level (feet) <u>40</u> below above top of ground.			
(4) casing <u>plastic</u> , <u>64</u> (material) (depth)			
<u>4</u> if telescope see back. (size)			
(5) screen <u>8</u> , <u>64</u> (length) (depth to top)			
<u>4</u> , <u>plastic</u> (size) (material)			
(6) pump <u>1/2</u> <u>10</u> (HP) (yield gpm)			
<u>Electric</u> (type power)			
(7) electric log <u>yes</u> (yes or no)			
<u>Organization running log</u> (organization running log)			
(8) how well bottom plugged <u>sand & gravel</u>			
DRILLERS REMARKS:			

CODED

OCT 9 1973

If well telescopes please sketch and show depths.

GROUND LEVEL

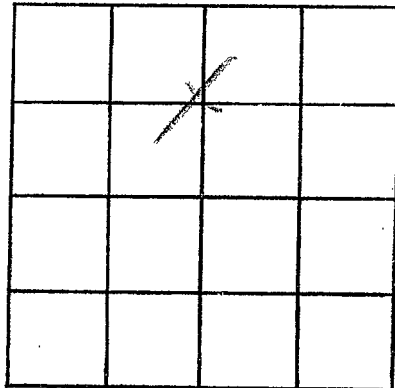

SECTION 33

Please indicate well location X.

ADDITIONAL INFORMATION

If more than one screen,
show locations of each on sketch.