

CODED

PIKE  
M 62  
9-17-73

MISSISSIPPI  
BOARD OF WATER COMMISSIONERS  
416 North State Street  
Jackson, Mississippi 39201

WATER WELL DRILLERS LOG

9-17 1973 *F. L. ...* *Peta*  
date well completed firm name county well located

LANDOWNER:  
*Charles Curry*  
*R.R. Magnolia*  
(mailing address)

description of formations encountered	from	to
	<i>Red Clay</i>	<i>6</i>
<i>Coarse sand + gravel</i>	<i>15</i>	<i>76</i>

WELL LOCATION:  
sec. *9* T. *1* N. R. *8* E  
*5* miles *NNE* of *Oxford*  
(distance) (direction) (nearest town)

WELL PURPOSE:  
*Home*  
(home, irrigation, municipal, industrial)

WELL COMPLETION DATA:

(1) diameter (inches) *4*

(2) total depth (feet) *76*

(3) static water level (feet) *50* below above top of ground.

(4) casing *plastic*, *68*,  
(material) (depth)  
*4* if telescope see back.  
(size)

(5) screen *8*, *68*  
(length) (depth to top)  
*4*, *plastic*  
(size) (material)

(6) pump *1/2*, *10*  
(HP) (yield gpm)  
*elec*  
(type power)

(7) electric log *no*  
(yes or no)  
(organization running log)

(8) how well bottom plugged *hard block*


CODED

DRILLERS REMARKS:

OCT 9 1973

If well telescopes please  
sketch and show depths.

GROUND LEVEL

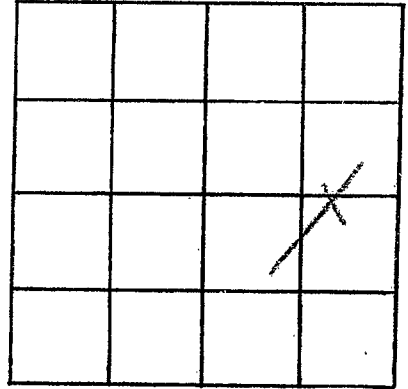

SECTION 9

Please indicate well location X.

ADDITIONAL INFORMATION

If more than one screen,  
show locations of each on sketch.