

PIKE
M 63
1-16-74

MISSISSIPPI
BOARD OF WATER COMMISSIONERS
416 North State Street
Jackson, Mississippi 39201

CODED

WATER WELL DRILLERS LOG

1-16 date well completed; 1974 firm name; Pike county well located

LANDOWNER:

Carol Estes
P.O. Box [unclear]
(mailing address)

description of formations encountered

from to

Red Clay	0	20
Red Chalk	20	45
Wash Gravel	45	115

WELL LOCATION:

sec. 2 T. 1 N. R. 1 E.
9 miles WSW of [unclear]
(distance) (direction) (nearest town)

WELL PURPOSE:
(home, irrigation, municipal, industrial)

CODED

WELL COMPLETION DATA:

- (1) diameter (inches) 4
- (2) total depth (feet) 115
- (3) static water level (feet) 70 below top of ground.
- (4) casing pipe 107, (material) (depth)
4 (size) if telescope see back.
- (5) screen 8, 107 (length) (depth to top)
4 (size) pipe (material)
- (6) pump 1/2 10 (HP) (yield gpm)
Ele (type power)
- (7) electric log ne (yes or no)
- (8) how well bottom plugged woody


DRILLERS REMARKS:

APR 22 1974

MISS. Bd. OF WATER COMMISSIONERS

If well telescopes please sketch and show depths.

GROUND LEVEL

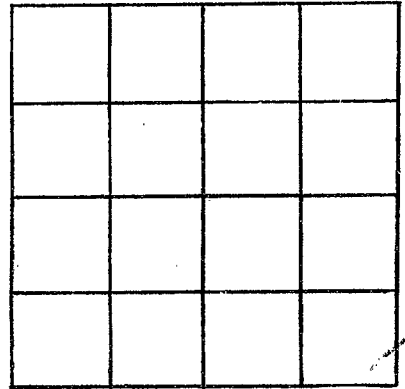

SECTION _____ 2

Please indicate well location X.

ADDITIONAL INFORMATION

If more than one screen, show locations of each on sketch.