

PIKE
M 65
1-15-75

MISSISSIPPI
BOARD OF WATER COMMISSIONERS
416 North State Street
Jackson, Mississippi 39201

WATER WELL DRILLERS LOG

Jan-15-1975 Chester Rivers Pike
date well completed firm name county well located

LANDOWNER:
Hedger Smith
Magnolia Pt.
(mailing address)

WELL LOCATION:
sec. 2 T. 1 N R. 9 E
11 miles east of Magnolia
(distance) (direction) (nearest town)

WELL PURPOSE: home
(home, irrigation, municipal, industrial)

- WELL COMPLETION DATA:
- (1) diameter (inches) 4"
 - (2) total depth (feet) 138
 - (3) static water level (feet) 90 below top of ground.
 - (4) casing Plastic 132
(material) (depth)
 - If telescope see back.
(size)
 - (5) screen 6' 132
(length) (depth to top)
 - 4 Plastic
(size) (material)
 - (6) pump 1/2 Sub 10
(HP) (yield gpm)
 - Electric
(type power)
 - (7) electric log no
(yes or no)
 - (organization running log)
 - (8) how well bottom plugged wood plug

description of formations encountered	from	to
Red sand clay	0	22
Red sand	22	76
sand & gravel	76	88
White Chalk	88	126
126-138		
coarse sand & small gravel	126	138

CODED


MISSISSIPPI
FEB 7 1975

MISS. BD. OF WATER COMMISSIONERS

DRILLERS REMARKS:
old well pit by highway
Casing Rusted

If well telescopes please sketch and show depths.

GROUND LEVEL

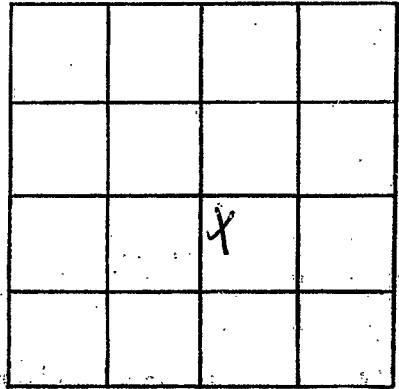

SECTION 2

Please indicate well location X.

ADDITIONAL INFORMATION

If more than one screen, show locations of each on sketch.