

PIKE
M66
1-1-75

MISSISSIPPI
BOARD OF WATER COMMISSIONERS
416 North State Street
Jackson, Mississippi 39201

WATER WELL DRILLERS LOG

CODED

1-1 19 75 *Fitzgerald* *Pike*
date well completed firm name county well located

LANDOWNER:
M. Strutt
Reb. Magnoli
(mailing address)

description of formations encountered	from	to
<i>Real clay</i>	<i>0</i>	<i>20</i>
<i>Real sand</i>	<i>20</i>	<i>110</i>
<i>concrete level + ground</i>	<i>110</i>	<i>120</i>

WELL LOCATION:
sec. *19* T *1* N R *9* E
1 miles *W* of *Piquemore*
(distance) (direction) (nearest town)

CODED

WELL PURPOSE: *Home*
(home, irrigation, municipal, industrial)


- WELL COMPLETION DATA:
- (1) diameter (inches) *4*
 - (2) total depth (feet) *120*
 - (3) static water level (feet) *80* below top of ground.
 - (4) casing *plastic*, *112*,
(material) (depth)
4 if telescope see back.
(size)
 - (5) screen *8*, *112*
(length) (depth to top)
4, *plastic*
(size) (material)
 - (6) pump *1/2*, *10*
(HP) (yield. gpm)
elec
(type power)
 - (7) electric log *no*
(yes or no)
 - (organization running log)
 - (8) how well bottom plugged *land slab*

DRILLERS REMARKS:

FEB 10 1975
MISS. Bd. OF WATER COMMISSIONERS

If well telescopes please sketch and show depths.

GROUND LEVEL

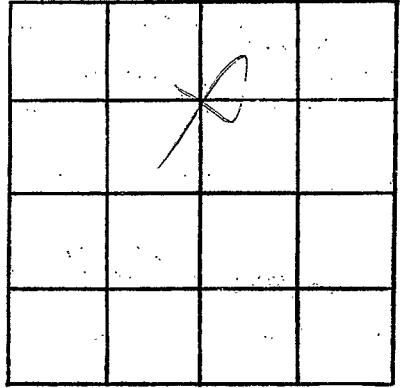

SECTION 19

Please indicate well location X.

ADDITIONAL INFORMATION

If more than one screen, show locations of each on sketch.