

PIKE
M69
2-10-75

MISSISSIPPI
BOARD OF WATER COMMISSIONERS CODED
416 North State Street
Jackson, Mississippi 39201

WATER WELL DRILLERS LOG

Pike

Feb 10 1975 Chester Reeves date well completed firm name county well located

LANDOWNER:
Mr. Gordon Brown
P.O. Box
(mailing address)

description of formations encountered	from	to
Red clay	0	17
Red sand	17	63
Sand & gravel	63	79
Coarse sand	79	76 1/2

WELL LOCATION:
sec. 22 T. 1 N. R. 9 E
2 1/2 miles S-SE of Progress
(distance) (direction) (nearest town)

WELL PURPOSE: Home
(home, irrigation, municipal, industrial)

- WELL COMPLETION DATA:
- (1) diameter (inches) 4"
 - (2) total depth (feet) 106
 - (3) static water level (feet) 75 below top of ground.
 - (4) casing plastic bottom (material) (depth)
 - (size) if telescope see back.
 - (5) screen 6 100's (length) (depth to top)
 - 4 Plastic (size) (material)
 - (6) pump 1/2 12 (HP) (yield gpm)
 - elect (type power)
 - (7) electric log no (yes or no)
 - (organization running log)
 - (8) how well bottom plugged wood plug

DRILLERS REMARKS:
all well bad


CODED

REGISTERED

FEB 21 1975

If well telescopes please sketch and show depths.

GROUND LEVEL

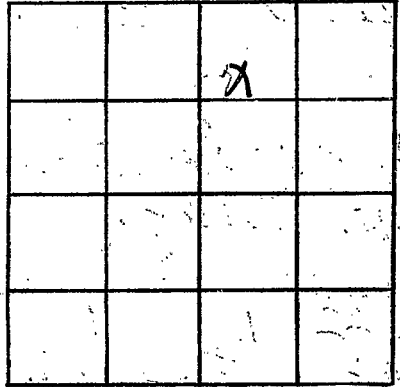

SECTION 22

Please indicate well location X.

ADDITIONAL INFORMATION

Lined area for additional information.

If more than one screen, show locations of each on sketch.