

Pipe  
M 71  
5-31-75

MISSISSIPPI  
 BOARD OF WATER COMMISSIONERS  
 416 North State Street  
 Jackson, Mississippi 39201

WATER WELL DRILLERS LOG

CODED

Pipe

May 31 1975 Recess Well Drilling county well located Pipe  
 date well completed firm name

LANDOWNER:  
Mr. Jerry Bullock  
Rt 2 - McComb  
 (mailing address)

description of formations encountered	from	to
<u>Clay</u>	<u>0</u>	<u>23</u>
<u>Red sand</u>	<u>22</u>	<u>38</u>
<u>hard ground</u>	<u>38</u>	<u>47</u>
<u>loamy</u>	<u>47</u>	<u>108</u>
<u>fine gravel sand</u>	<u>108</u>	<u>115</u>

WELL LOCATION:  
 sec. 14 T-1 N R-9 E 132  
3 1/2 miles east Recess  
 (distance) (direction) (nearest town)


WELL PURPOSE: drain barn  
 (home, irrigation, municipal, industrial)

- WELL COMPLETION DATA:
- (1) diameter (inches) 4"
  - (2) total depth (feet) 115
  - (3) static water level (feet) 58 below top of ground
  - (4) casing plastic bottom (material) (depth)
  - (5) screen 6' 109 (length) (depth to top)  
4" plastic (size) (material)
  - (6) pump leathers (HP) (yield gpm)  
elect (type power)
  - (7) electric log no (yes or no)
  - (organization running log)

(8) how well bottom plugged  
wooden plug


DRILLERS REMARKS:  
 \_\_\_\_\_  
 \_\_\_\_\_

CODED

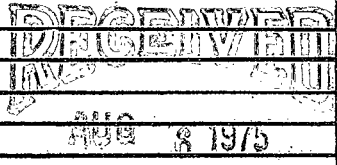

If well telescopes please sketch and show depths.

GROUND LEVEL

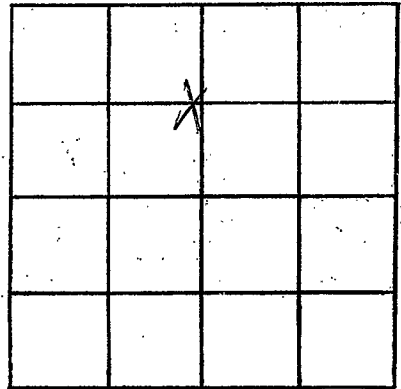

SECTION 1/1

Please indicate well location X.

ADDITIONAL INFORMATION

If more than one screen, show locations of each on sketch.