

Pine
M 73
8-5-75

MISSISSIPPI
BOARD OF WATER COMMISSIONERS
416 North State Street
Jackson, Mississippi 39201

CODED

WATER WELL DRILLERS LOG

August 5 1975 Reverend Well Drilling Pine
day well completed firm name county well located

LANDOWNER:
Bobby Sterling
At 2 m.c. Conley
(mailing address)

description of formations encountered	from	to
	<u>Red Clay</u>	<u>0</u>
<u>Red Chalk</u>	<u>12</u>	<u>50</u>
<u>Small & gravel</u>	<u>50</u>	<u>80</u>


WELL LOCATION:
sec. 5 T-1 N R-9 E 137
4 miles North of Proctor
(distance) (direction) (nearest town)

CODED

WELL PURPOSE: Trailer
(home, irrigation, municipal, industrial)

- WELL COMPLETION DATA:
- (1) diameter (inches) 4"
 - (2) total depth (feet) 80
 - (3) static water level (feet) 44 ^{above} below top of ground.
 - (4) casing plastic bottom
(material) (depth)
 - ✓ If telescope see back.
(size)
 - (5) screen 6" 72
(length) (depth to top)
 - 4" plastic
(size) (material)
 - (6) pump by other
(HP) (yield gpm)
 - elect
(type power)
 - (7) electric log no
(yes or no)
 - (organization running log)
 - (8) how well bottom plugged Washed


DRILLERS REMARKS:
no remark

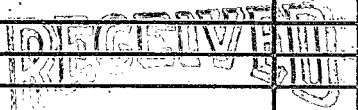

OCT - 6 1975

If well telescopes please sketch and show depths.

GROUND LEVEL

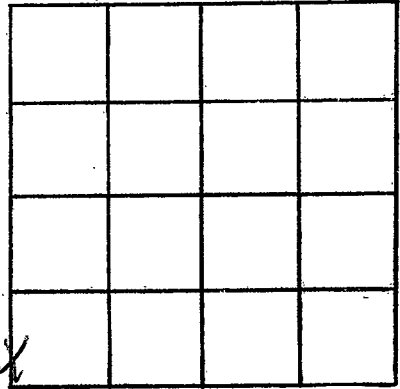

SECTION 05

Please indicate well location X.

ADDITIONAL INFORMATION

If more than one screen, show locations of each on sketch.