

Pipe
M 75
7-15-75

MISSISSIPPI
 BOARD OF WATER COMMISSIONERS
 416 North State Street
 Jackson, Mississippi 39201

CODED

WATER WELL DRILLERS LOG

July 12 1975 Keuss Well Drilling Pipe
 date well completed firm name county well located

LANDOWNER:
Mr. Clyde Whittington
3212 main, Belvoir, La.
 (mailing address)

description of formations encountered	from	to
<u>Red sandy clay</u>	<u>0</u>	<u>15</u>
<u>granit sand Chalk</u>	<u>15</u>	<u>70</u>
<u>Gravel & sand</u>	<u>70</u>	<u>95</u>
<u>pink Chalk</u>	<u>95</u>	<u>123</u>
<u>San. River sand</u>	<u>123</u>	<u>139</u>

WELL LOCATION:
 sec. 11 T 1 N R 9 E 134
4 miles ENE of Progers
 (distance) (direction) (nearest town)

WELL PURPOSE: Dom
 (home, irrigation, municipal, industrial)

WELL COMPLETION DATA:

(1) diameter (inches) 4"

(2) total depth (feet) 139

(3) static water level (feet) 85 below top of ground.

(4) casing plastic bottom
 (material) (depth)

6 if telescope see back.
 (size)

(5) screen 6' 133
 (length) (depth to top)

4" plastic
 (size) (material)

(6) pump 1/2 8
 (HP) (yield gpm)

elect
 (type power)

(7) electric log no
 (yes or no)

(organization running log)

(8) how well bottom plugged
water plug


DRILLERS REMARKS:
2' well plugged out

INTEGRITY
 REC'D
 OCT - 6 1975

MISS. BD. OF WATER COMMISSIONERS

If well telescopes please sketch and show depths.

GROUND LEVEL

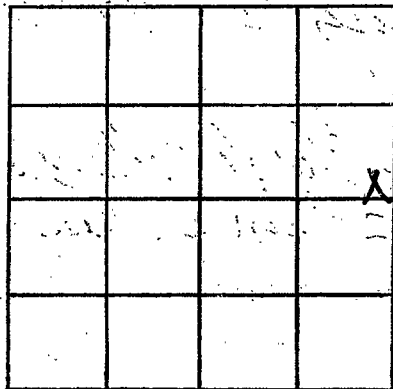

SECTION 11

Please indicate well location X.

ADDITIONAL INFORMATION

If more than one screen, show locations of each on sketch.