

PIKE
M 76
10-14-79

MISSISSIPPI
BOARD OF WATER COMMISSIONERS
416 North State Street
Jackson, Mississippi 39201

CODED

WATER WELL DRILLERS LOG

10-14 1979 Fitzgibbon Well Serv Pike
date well completed firm name county well located

LANDOWNER:
Progress Fire Dept
R.B. Marnolia, Jr.
(mailing address)

description of formations encountered	from	to
<u>Red clay</u>	<u>0</u>	<u>20</u>
<u>Red sand & gravel</u>	<u>20</u>	<u>96</u>
<u>White clay</u>	<u>96</u>	<u>200</u>
<u>Course sand & gravel</u>	<u>200</u>	<u>230</u>

WELL LOCATION:
sec. 17 T. 1 N. R. 9 E
1/4 miles of Progress
(distance) (direction) (nearest town)

WELL PURPOSE: H
(home, irrigation, municipal, industrial)

- WELL COMPLETION DATA:
- (1) diameter (inches) 4
 - (2) total depth (feet) 230
 - (3) static water level (feet) 90 below top of ground.
 - (4) casing PVC 2 1/4
(material) (depth)
4 if telescope see back.
(size)
 - (5) screen 16 2 1/4
(length) (depth to top)
4 PVC
(size) (material)
 - (6) pump 3 60
(HP) (yield gpm)
Elco
(type power)
 - (7) electric log no
(yes or no)
(organization running log)
 - (8) how well bottom plugged Sand shot

CODED

DRILLERS REMARKS:


DEPT. OF NATURAL RESOURCES
BUREAU OF LAND & WATER RESOURCES

NOV - 7 1979

RECEIVED

If well telescopes please sketch and show depths.

GROUND LEVEL

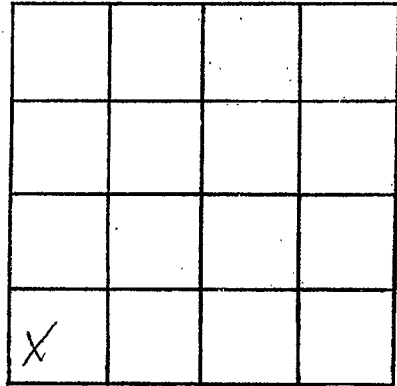

SECTION 17

Please indicate well location X.

ADDITIONAL INFORMATION

A series of horizontal lines for writing additional information.

If more than one screen, show locations of each on sketch.