

PIPE
M 78
6-4-80
June 4 1980
date well completed

MISSISSIPPI
BOARD OF WATER COMMISSIONERS
416 North State Street
Jackson, Mississippi 39201

CODED

WATER WELL DRILLERS LOG

80 Reems Miller Pipe
firm name county well located

LANDOWNER:
John Hall III
 Rt Magnolia
(mailing address)

| description of formations encountered | from | to |
|---------------------------------------|------------|------------|
| <u>Clay</u> | <u>0</u> | <u>25</u> |
| <u>Red sand</u> | <u>25</u> | <u>65</u> |
| <u>Chalky sand</u> | <u>65</u> | <u>95</u> |
| <u>sand & gravel</u> | <u>95</u> | <u>110</u> |
| <u>Red sand</u> | <u>110</u> | <u>130</u> |
| <u>Red gravel & sand</u> | <u>130</u> | <u>167</u> |

WELL LOCATION:
sec. 34 T-1 N R-9 E
4 miles S-SE of Progre
(distance) (direction) (nearest town)

WELL PURPOSE: Municipal
(home, irrigation, municipal, industrial)

WELL COMPLETION DATA:
(1) diameter (inches) 4"
(2) total depth (feet) 167"
(3) static water level (feet) 87 below top of ground.
(4) casing plastic bottom
(material) (depth)
_____ if telescope see back.
(size)
(5) screen 20" 147"
(length) (depth to top)
4" plastic
(size) (material)
(6) pump Hyatt 100
(HP) (yield gpm)
shot
(type power)
(7) electric log no
(yes or no)
_____ (organization running log)

(8) how well bottom plugged
wooden plug
DRILLERS REMARKS:


DEPT. OF NATURAL RESOURCES
BUREAU OF LAND & WATER RESOURCES

FEB 2 1981

RECEIVED

If well telescopes please sketch and show depths.

GROUND LEVEL

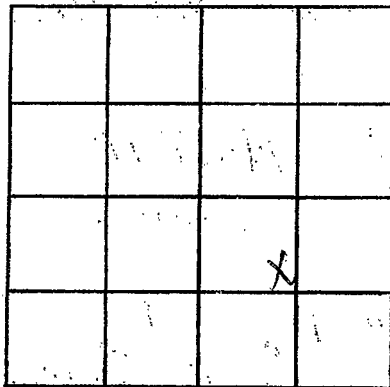

SECTION 34

Please indicate well location X.

ADDITIONAL INFORMATION

If more than one screen, show locations of each on sketch.