

Pike
M 79
9-29-75

MISSISSIPPI BOARD OF WATER COMMISSIONERS
 416 North State Street
 Jackson, Mississippi 39201

WATER WELL DRILLERS LOG

COPIED

9-29 date well completed 1975 Fitzgerald & Co Inc firm name Pike county well located

LANDOWNER:

Ewell Estes

R.R. Mosculin
 (mailing address)

WELL LOCATION:

sec. 27 1 N S R. 9 E W
12 miles E of Mosculin
 (distance) (direction) (nearest town)

WELL PURPOSE: Water
 (home, irrigation, municipal, industrial)

WELL COMPLETION DATA:

- (1) diameter (inches) 4
- (2) total depth (feet) 120
- (3) static water level (feet) 70 below above top of ground.
- (4) casing plastic 112
 (material) (depth)
4 If telescope see back.
 (size)
- (5) screen 8 112
 (length) (depth to top)
4 plastic
 (size) (material)
- (6) pump 1 8
 (HP) (yield gpm)
elec
 (type power)
- (7) electric log no
 (yes or no)
 (organization running log)
- (8) how well bottom plugged Sandblock

description of formations encountered

from to


red clay 0 20
red sand 20 40
white chalk 40 109
brown sand & gravel 109 120

DRILLERS REMARKS:

RECEIVED
 MISSISSIPPI BOARD OF WATER COMMISSIONERS
 OCT 18 1975
 MISS. BD. OF WATER COMM.

If well telescopes please sketch and show depths.

GROUND LEVEL

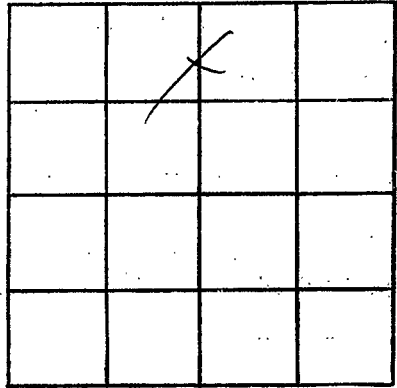

SECTION ~~2~~ 2

Please indicate well location X.

ADDITIONAL INFORMATION

If more than one screen, show locations of each on sketch.