

MISSISSIPPI DEPARTMENT OF NATURAL RESOURCES

Bureau of Land and Water Resources

Southport, Miss

P.O. Box 10631

Jackson, Mississippi 39209

WATER WELL DRILLERS LOG

CODED

PIKE  
M80  
7/28/81

July 28, 1981 Anna Miller Pike  
date well completed firm name county well located

LANDOWNER:  
Raymond Giffens  
At 2 - M G. Corbin  
(mailing address)

description of formations encountered	from	to
	sandy clay	0
Red sand	16	30
Red Chalk	30	48
Coarse sand	48	80
sandy rubble	80	112
pea gravel & sand	112	130

WELL LOCATION:  
sec 26 T 1 N R 9 E  
4 miles ESE of Proctor  
(distance) (direction) (nearest town)

WELL PURPOSE: irrigation  
(home, irrigation, municipal, industrial)

WELL COMPLETION DATA:

- (1) diameter (inches) 4"
- (2) total depth (feet) 130
- (3) static water level (feet) 70' below top of ground
- (4) casing plastic, pattern (material) (depth)
- (5) screen 15' length, 15' depth to top
- (6) pump 3/4" (size), plastic (material), 3/4 HP (HP), 65 (yield gpm)
- (7) electric log no (yes or no)

CODED

(organization running log)

(8) how well bottom plugged  
Back used valve

DRILLERS REMARKS:


DEPT. OF NATURAL RESOURCES  
BUREAU OF LAND & WATER RESOURCES

FEB - 8 1982

RECEIVED

If well telescopes please sketch and show depths.

GROUND LEVEL

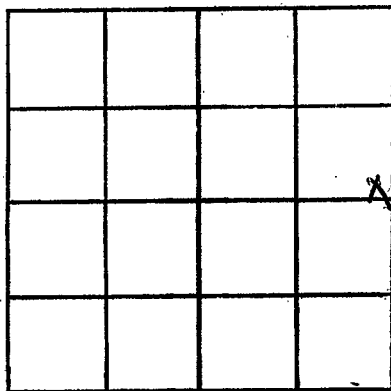

SECTION 26

Please indicate well location X.

ADDITIONAL INFORMATION

If more than one screen,  
show locations of each on sketch.