

MISSISSIPPI DEPARTMENT OF NATURAL RESOURCES

Bureau of Land and Water Resources

Southport Mall

P.O. Box 10631

Jackson, Mississippi 39209

WATER WELL DRILLERS LOG

PIKE  
M81  
4-8-85

4-8 1985 F. G. Lawrence, Inc. Pre  
date well completed firm name county well located

LANDOWNER: Harrison Allen  
R.R. Magnolia ms.  
(mailing address)

WELL LOCATION:  
sec. 7 T. 1 (N) S R. 9 (E) W  
2 miles H off Highway  
(distance) (direction) (nearest town)

WELL PURPOSE: Home  
(home, irrigation, municipal, industrial)

- WELL COMPLETION DATA:
- (1) diameter (inches) 4
  - (2) total depth (feet) 135
  - (3) static water level (feet) 100 below above top of ground.
  - (4) casing PC 125  
(material) (depth)  
4 if telescope see back.  
(size)
  - (5) screen 10 125  
(length) (depth to top)  
4 PC  
(size) (material)
  - (6) pump 1/2 10  
(HP) (yield gpm)  
Electric  
(type power)
  - (7) electric log No  
(yes or no)  
(organization running log)
  - (8) how well bottom plugged Sealed

description of formations encountered	from	to
<u>Red clay</u>	<u>0</u>	<u>20</u>
<u>white chalk</u>	<u>20</u>	<u>90</u>
<u>Red sand</u>	<u>90</u>	<u>120</u>
<u>Coarse sand &amp; gravel</u>	<u>120</u>	<u>135</u>

RECEIVED


MAY 17 1985

DRILLERS REMARKS:

Department of Natural Resources  
Bureau of Land & Water Resources

If well telescopes please sketch and show depths.

GROUND LEVEL

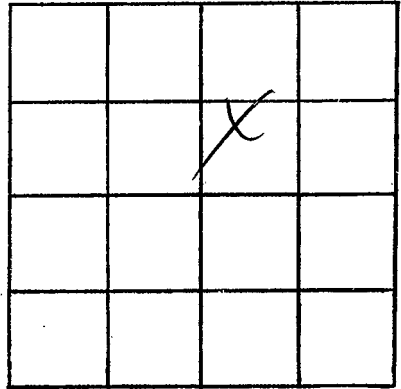

SECTION 7

Please indicate well location X.

ADDITIONAL INFORMATION

If more than one screen,  
show locations of each on sketch.