

MISSISSIPPI DEPARTMENT OF ENVIRONMENTAL QUALITY

Office of Land and Water Resources

P. O. Box 10631
Jackson, MS 39289-0631
WATER WELL DRILLERS LOG

COUNTY WELL LOCATED
Whe

WELL NUMBER M-24 CODED

DATE WELL COMPLETED
2-11-03

PERMIT NUMBER

NAME OF DRILLING FIRM
Enterprise Well Service

NAME & MAILING ADDRESS OF LANDOWNER
Bobby Carson
Silver Dr.

Latitude:
Longitude:

WELL LOCATION. SEC 10 TOWNSHIP 1 N RANGE 9 E

DISTANCE 10 Miles DIRECTION NE of NEAREST TOWN Osyka

OTHER LANDMARK

WELL PURPOSE Home Irrigation, Municipal, Industrial, Fish Pond, etc.

PUMP DATA

PUMP TYPE (Circle One):
 Submersible Turbine, Jet Flowing Well,
Other (Describe) _____

POWER TYPE (Circle One):
 Electric Tractor, Diesel, Gasoline, Butane,
Other (Describe) _____ H/P 1/2

DESCRIPTION OF FORMATIONS ENCOUNTERED	FROM	TO
<u>Clay</u>	<u>0</u>	<u>30</u>
<u>Sand</u>	<u>30</u>	<u>60</u>
<u>Clay</u>	<u>60</u>	<u>80</u>
<u>Sand & gravel</u>	<u>80</u>	<u>100</u>
<u>Clay</u>	<u>100</u>	<u>110</u>
<u>Sand</u>	<u>110</u>	<u>120</u>
<u>Coarse Sand</u>	<u>120</u>	<u>127</u>

RECEIVED

MAR 17 2003

BY: OLWR

Top of Lap Pipe or Reduction in Casing

FEET IF TELESCOPED OR MORE THAN ONE SCREEN: USE BACK PAGE

WELL DATA

Well Depth 127' Casing Diameter (In.) 4" Casing Length (Ft.) 117'

Type of Casing PVC Hole Depth 127' Depth to Static Water Level 96'

TYPE OF COMPLETION: (Circle One or More):
 Gravel Packed Underreamed, Telescoped,
 Natural Development, Open Hole, Other
(Describe) _____

WELL GROUTED TO A DEPTH OF 10 FEET
Type Grout (circle one): Cement, Bentonite, or Mix

SCREEN DATA

Diameter - Inches 4" Length - Feet 10' Slot Size - Inches 0.02

Screen Type PVC Depth to Bottom - Feet 127'

I certify that the well was drilled, constructed and completed in accordance with all applicable Requirements of the Mississippi Department of Environmental Quality and/or the Mississippi Department of Health regulations and state laws.


Brad Steward 0291
Signature of Licensed Driller and License No.

2-8-03.
Date

Additional Information Required On Back

If well telescopes please sketch and show depths.

GROUND LEVEL

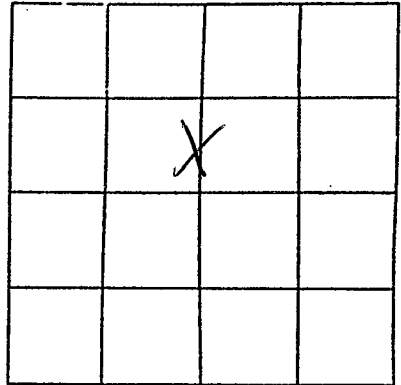

SECTION 10

Please indicate well location X.

Pump Capacity (GPM)	No. of Stages	Setting Depth
<u>12</u>	<u>8</u>	<u>110"</u> FT.
PUMP TEST		
Well yielded _____ GPM with a drawdown of _____ ft. after _____ hours of pumping		

LOG DATA

TYPE OF LOG RUN (Circle One):	No Log Run,
Electric, Gamma Ray, Density, Sonic, Neutron,	
Other (Describe) _____	
Name of Organization Running Log _____	

GEOLOGIC DATA (Office Use Only)

Surface Elev.	Geologic Unit	Unit Thickness	Depth to Top
Subs. SWL	Date	Analysis	Aquifer Test

Driller's Remarks

If more than one screen, show location of each on sketch.