
	State Well Report	For Office Use Only:	
County: Aike	Part 1 – Driller's Log		
Permit #:	Mississippi Department of Environmental Quality Office of Land and Water Resources	Aquifer:	
Driller: JC, Sum VAI	P.O. Box 10631	well #: <u>M-121</u>	
	Jackson, MS 39289-0631	L. S. Elevation:	
Da., dri 11 3 mpleted: <u>6/26/08</u>	(601)961-5210 (601)254 (628 (5m)		
	(601)354-6938 (fax)	E-log #:	
	rt be prepared by the license holder respons ble for		
Department at the above address Information on Well	s within 30 days of completion of drilling of the wel		
(Landowner if borehole is not f	for a water well)	orehole Location	
		_" Longitude:'	
	Method of Lat/Long circle o	one): Conventional Survey,	
Mailing Address: 2097 Joe Tucker Rd		,	
W. Comle, Y	USGS quad, Hand-heid	I GPS, Survey-grade GPS	
<del>,,,,,,,,,,,,,,,,,,,,,,,,,,,,,,,,,,</del>	¼ ¼ S x _ 2	Z Twn IN Rng	
City Sta	te Zip Code Distance Direction	Nearest Town	
Telephone No. (285-516-9		of MAGNO/iA	
	110		
···	Well / Borehole Data		
Date drilling started: 6/26/08Date dr	rilling completed: 6/26/08 Hole depth: 80	Hole diameter: 71	
Logation of the second of	er used for drilling: POTA le Water		
Method of dosing and volume of Chlorin	er used for drilling: <u>YUI/TUIC</u> <u>UB</u>	-	
Name of organization running log(s):	n Electric Gamma Ray Density Sonic Neutron	Other:	
	Vell Geotechnical/Geological Investigation Ground		
Purpose of borehole (check one): Water W Seismic S	Vell <u>Geotechnical/Geological Investigation</u> Ground	d Source Heat Pump	
Purpose of borehole (check one): Water W Seismic S	Vell <u>Geotechnical/Geological Investigation</u> Ground Survey Other ( <i>describe</i> ) <u>Ito water well construction, skip the remainder (f this bl</u>	d Source Heat Pump	
Purpose of borehole (check one): Water W Seismic S	Vell <u>Geotechnical/Geological Investigation</u> Ground	d Source Heat Pump	
Purpose of borehole (check one): Water W Seismic S If drilling is not related Purpose of Well (check one): Home	Vell <u>Geotechnical/Geological Investigation</u> Ground Survey Other ( <i>describe</i> ) <u>to water well construction, skip the remainder (f this bl</u> ndustrial Public Supply Irrigation Fish Culture	d Source Heat Pump	
Purpose of borehole (check one): Water W Seismic S If drilling is not related Purpose of Well (check one): Home	Vell <u>Geotechnical/Geological Investigation</u> Ground Survey Other ( <i>describe</i> ) <u>to water well construction, skip the remainder (f this bl</u> ndustrial Public Supply Irrigation Fish Culture	d Source Heat Pump	
Purpose of borehole (check one): Water W Seismic S <i>If drilling is not related</i> Purpose of Well (check one): Home I If a flowing well, method of flow regulatio Static Water Level: <u>45</u> feet ab	VellGeotechnical/Geological InvestigationGround SurveyOther ( <i>describe</i> ) <u>I to water well construction, skip the remainder (f this bl</u> ndustrialPublic SupplyIrrigationFish Culture on: ValveOther (describe) pove of below (circle one) land surface Date m( asured:	d Source Heat Pump	
Purpose of borehole (check one): Water W Seismic S If drilling is not related Purpose of Well (check one): Home I If a flowing well, method of flow regulatio Static Water Level:	Vell       Geotechnical/Geological InvestigationGround         SurveyOther (describe)	d Source Heat Pump	
Purpose of borehole (check one): Water W Seismic S If drilling is not related Purpose of Well (check one): Home I If a flowing well, method of flow regulation Static Water Level:	Vell       Geotechnical/Geological InvestigationGround         SurveyOther (describe)	d Source Heat Pump	
Purpose of borehole (check one): Water W Seismic S If drilling is not related Purpose of Well (check one): Home In If a flowing well, method of flow regulation Static Water Level:	Vell       Geotechnical/Geological InvestigationGround         SurveyOther (describe)	d Source Heat Pump	
Purpose of borehole (check one): Water W Seismic S If drilling is not related Purpose of Well (check one): Home In If a flowing well, method of flow regulation Static Water Level:	Vell       Geotechnical/Geological InvestigationGround         SurveyOther (describe)	d Source Heat Pump bckOther: b/2b/08 hent Bentonite $Mix$ $PVC$	
Purpose of borehole (check one): Water W Seismic S If drilling is not related Purpose of Well (check one): Home In If a flowing well, method of flow regulation Static Water Level:	Vell       Geotechnical/Geological InvestigationGround         SurveyOther (describe)	d Source Heat Pump bckOther: b/2b/08 hent Bentonite $Mix$ $PVC$	
Purpose of borehole (check one): Water W Seismic S If drilling is not related Purpose of Well (check one): Home I If a flowing well, method of flow regulation Static Water Level:	Vell       Geotechnical/Geological InvestigationGround         SurveyOther (describe)	d Source Heat Pump	
Purpose of borehole (check one): Water W Seismic S If drilling is not related Purpose of Well (check one): Home I If a flowing well, method of flow regulation Static Water Level: <u>45</u> feet ab Method of Measurement (circle one) st Well depth: <u>80</u> Well grouted to a dep Casing length: <u>10</u> feet Casing Screen length: <u>10</u> feet Screen Screen slot size: <u>1010</u> inches	Vell       Geotechnical/Geological InvestigationGround         SurveyOther (describe)	d Source Heat Pump ock Other: 6/26/08 ment Bentonite Mix PVC	
Purpose of borehole (check one): Water W Seismic S If drilling is not related Purpose of Well (check one): Home I If a flowing well, method of flow regulation Static Water Level: <u>45</u> feet ab Method of Measurement (circle one) st Well depth: <u>80</u> Well grouted to a dep Casing length: <u>10</u> feet Casing Screen length: <u>10</u> feet Screen Screen slot size: <u>1010</u> inches	Vell       Geotechnical/Geological InvestigationGround         SurveyOther (describe)	d Source Heat Pump ock Other: 6/26/08 ment Bentonite Mix PVC P	
Purpose of borehole (check one): Water W Seismic S If drilling is not related Purpose of Well (check one): Home I If a flowing well, method of flow regulation Static Water Level: <u>45</u> feet ab Method of Measurement (circle one) st Well depth: <u>80</u> Well grouted to a dep Casing length: <u>10</u> feet Casing Screen length: <u>10</u> feet Screen Screen slot size: <u>1010</u> inches	Vell       Geotechnical/Geological InvestigationGround         SurveyOther (describe)	d Source Heat Pump ock Other: bf / 2b / 08 ent Bentonite $Mix$ f VC f VC f VC f Occ ect hole Natural Development	
Purpose of borehole (check one): Water W Seismic S If drilling is not related Purpose of Well (check one): Home I If a flowing well, method of flow regulation Static Water Level: I Method of Measurement (circle one) (st Well depth: SO Well grouted to a dep Casing length: I Casin Screen length: I Casin Screen slot size: I CI C inches Type of completion (circle all applicable):	Vell       Geotechnical/Geological InvestigationGround         SurveyOther (describe)          Ito water well construction, skip the remainder (f this bl         IndustrialPublic SupplyIrrigationFish Culture         on: ValveOther (describe)        Other (describe)         prove of below (circle one) land surface         Date mc asured:         geel tape         electric tape         air line         other:         upth offeet         Type of grout (circle one): N eat Cemp         ng diameter:        inches         Setting depth:         From<	d Source Heat Pump	
Purpose of borehole (check one): Water W Seismic S If drilling is not related Purpose of Well (check one): Home I If a flowing well, method of flow regulation Static Water Level: I Method of Measurement (circle one) (st Well depth: SO Well grouted to a dep Casing length: I Casin Screen length: I Casin Screen slot size: I CI C inches Type of completion (circle all applicable):	Vell       Geotechnical/Geological Investigation 'Ground         SurveyOther (describe)	d Source Heat Pump	
Purpose of borehole (check one): Water W Seismic S If drilling is not related Purpose of Well (check one): Home I If a flowing well, method of flow regulation Static Water Level:	Vell       Geotechnical/Geological InvestigationGround         SurveyOther (describe)          Ito water well construction, skip the remainder (f this bl         IndustrialPublic SupplyIrrigationFish Culture         on: ValveOther (describe)        Other (describe)         prove of below (circle one) land surface         Date mc asured:         geel tape         electric tape         air line         other:         upth offeet         Type of grout (circle one): N eat Cemp         ng diameter:        inches         Setting depth:         From<	d Source Heat Pump ockOther: b/2b/08 ent Bentonite $Mix$ PVC PVC PVC Rother feet hole Natural Development en, describe on next page Form: OLWR-SV	
Purpose of borehole (check one): Water W Seismic S If drilling is not related Purpose of Well (check one): Home I If a flowing well, method of flow regulation Static Water Level: I Method of Measurement (circle one) (st Well depth: SO Well grouted to a dep Casing length: I Casin Screen length: I Casin Screen slot size: I CI C inches Type of completion (circle all applicable):	Vell       Geotechnical/Geological Investigation Ground         SurveyOther (describe)	d Source Heat Pump	
Purpose of borehole (check one): Water W Seismic S If drilling is not related Purpose of Well (check one): Home I If a flowing well, method of flow regulation Static Water Level:	Vell       Geotechnical/Geological InvestigationGround         SurveyOther (describe)          Ito water well construction, skip the remainder (f this bl         IndustrialPublic SupplyIrrigationFish Culture         on: ValveOther (describe)        Other (describe)         prove of below (circle one) land surface         Date mc asured:         geel tape         electric tape         air line         other:         upth offeet         Type of grout (circle one): N eat Cemp         ng diameter:        inches         Setting depth:         From<	d Source Heat Pump	
Purpose of borehole (check one): Water W Seismic S If drilling is not related Purpose of Well (check one): Home I If a flowing well, method of flow regulation Static Water Level:	Vell       Geotechnical/Geological Investigation 'Ground         SurveyOther (describe)	d Source Heat Pump	
Purpose of borehole (check one): Water W Seismic S If drilling is not related Purpose of Well (check one): Home I If a flowing well, method of flow regulation Static Water Level:	Vell       Geotechnical/Geological Investigation Ground         SurveyOther (describe)	d Source Heat Pump ockOther: b/2b/08 ent Bentonite $Mix$ PVC PVC PVC ent hole Natural Development ent describe on next page Form: OLWR-SW	


M-121

Description of format ons encountered must be provided for all

The sketch	below only	required f	or	<u>water wells</u>

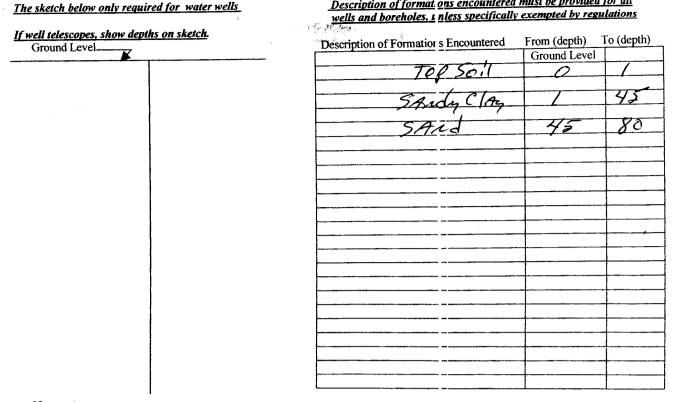

If more than one screen, show location of each on sketch

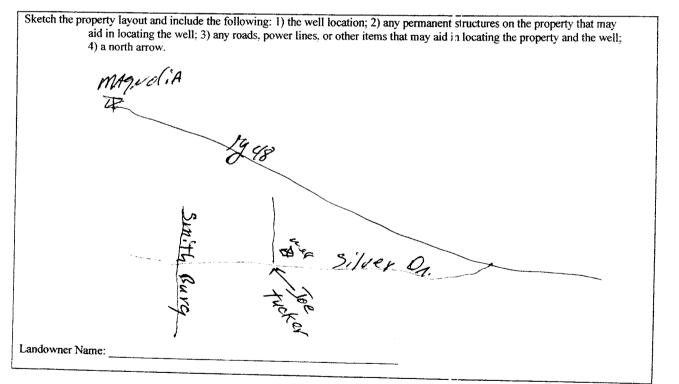

I certify that the well/borehole was drilled, constructed, and completed in accordance with all applicable requirements of the Form: OLWR-SWR-1A Mississippi Department of Environmental Quality and the Mississippi Department of Health regulations, if applicable, and state

Endpulled Ser. 0-508 6/26/08\_ Sig mture

RE

Print Name of Responsible Licensee and License No.

JUL 07 2008 **BY: OLWR** 

EIVE

D

<b>STATE W</b>	ELL REPORT		
Permit #:Pump InstallerPermit #:Mississippi DepartmeDriller: $\overline{J_1 C_L S_{II} m \gamma A}/($ Date completed: $6/2.6/08$ (60)			
Well Owner Information	Well Location		
Owner Name: <u>Greg Tullos</u> Mailing Address: <u>2097 Toe Tucker</u> Rd <u>McCombrecker</u> Rd <u>City State Zip Code</u> Telephone No. <u>985-516-9190</u>	Latitude:          Method of Lat/Long (check one): Conventional Survey,         USGS quad, Hand-held GPS, Survey-grade GPS        /4/4_ Siec 2.2_T_/R_9         Distance       Disection         Nearest Town        8_ Miles _S_Eof		
Pump Type       Circle one	Power Type           Circle one           Diesel Engine         Gasoline Engine   Natural Gas		
Bucket Piston Turbine	Electric Motor Hand Tractor PTO		
Centrifugal Rotary Flowing Well Other (specify): Date Pump Installed: $\frac{6/26/08}{10}$ Rated Pump Capacity: $10$ Gallons Per Minute	Windmill     Other (specify):       Horse Power Rating of Motor:/z       Setting Depth:		
Pump Test DataDate Well Tested: $b / 2 b / 0 8$ Static Water Level (A): $45$ Feet Below Land SurfacePumping Water Level (B): $4$ Feet Below Land SurfaceDrawdown [(B) – (A)]:Feet Below Land SurfaceTest Pumping Rate:Gallons Per MinuteDuration of Pump Test (minimum 4 hours):Hours	Methi d of Measuring Water Level Circle one         Air Line       Electric Measuring Line       Steel Tape         Other (specify):		
Duration of Pump Test (minimum 4 hours):	fect afterhours of pumping		

.

JUL 07 2008 BY: OLWR