

43

STATE WELL REPORT

361

County: Pike
 Permit #: _____
 Driller: Fitzgerald Well Service
 Date drilling completed: 5-9-18

Part 1
Driller's Log
 Mississippi Department of Environmental Quality
 Office of Land and Water Resources
 P.O. Box 2309
 Jackson, MS 39225-2309
 (601)961-5555
 (601)961-5228 (fax)

For Office Use Only:
 Well #: M178
 Aquifer: _____
 E-Log #: _____

State Law requires that this report be prepared by the license holder responsible for the work and filed with the Department at the above address within 30 days of completion of drilling of the well or borehole.

Well Owner Information <small>(Landowner if borehole is not for a water well)</small>	Well or Borehole Location
Owner Name: <u>Mark Harrison</u>	Latitude: <u>30° 4' 9.7"</u> Longitude: <u>90° 16' 1.2"</u>
Mailing Address: <u>Meroux Valley</u>	Method of Lat/Long (check one): Conventional Survey _____
<u>Boyers</u> City <u>MS</u> State Zip Code _____	USGS quad _____, Hand-held GPS _____, Survey-grade GPS _____
Telephone No. (____) _____	<u>SW 1/4 NE 1/4, Sec 11 T 1 N R 9 E</u>
	____ Miles _____ of _____ (Distance) (Direction) (Nearest Town)

Well / Borehole Data

Date drilling started: 5-9-18 Date drilling completed: 5-9-18 Hole depth: 148' Hole diameter: 8"

Location of the source of any surface water used for drilling: _____

Method of dosing and volume of Chlorine used in drilling and development: _____

Logs run (check all applicable): Log run Electric Gamma Ray Density Sonic Neutron Other: _____

Name of organization running log(s): _____

Purpose of borehole (check one): Water Well Geotechnical/Geological Investigation Ground Source Heat Pump
 Seismic Survey Other (describe) _____

If drilling is not related to water well construction, skip the remainder of this block

Purpose of Well (check all applicable): Home Industrial Public Supply Irrigation Fish Culture
 Other (describe): Poultry House

If a flowing well, method of flow regulation: Valve _____ Other (describe) _____

Static Water Level: 25' feet above or below land surface Date measured: 5-9-18
(check one)

Method of measurement (check one) Steel tape Electric tape Air line Other (describe): _____

Well depth: 148' Well grouted to a depth of: 40' feet Type of grout (check one) Neat Cement Bentonite Mix

Casing length: 128' feet Casing diameter: 4" inches Type of casing: Pvc

Screen length: 20' feet Screen diameter: 4" inches Type of screen: Pvc

Screen slot size: .010 inches Setting depth: From 128' feet to 148' feet

Type of completion (check all applicable) gravel packed Underreamed Open hole Natural Development

Other (describe): _____

Top of lap pipe or reduction in casing: _____ feet

If telescoped or more than one screen, describe on next page

FILED
 MAY 23 2018
 OLWR

#3.

STATE WELL REPORT

Part 2

Pump Installer's Completion Report
 Mississippi Department of Environmental Quality
 Office of Land and Water Resources
 P.O. Box 2309
 Jackson, MS 39225-2309
 (601)961-5210
 (601) 360-0535 (fax)

For Office Use Only:

Well #: M178
 Aquifer: _____

County: Itke
 Permit #: _____
 Driller: Fitzgerald Well Services
 Date completed: 5-9-18
Copy information from block on Part 1

This part of the report must be completed by a licensed water well contractor or a licensed pump installer. A copy of Part 1 of the report must be attached and both parts filed with the Department at the above address within 30 days of well completion.

Well Owner Information			Well Location		
Owner Name: <u>Mark Harrison</u>	Latitude: <u>30° 4' 9.7"</u>		Longitude: <u>90° 16' 1.2"</u>		
Mailing Address: <u>Resand Valley</u>	Method of Lat/Long (check one): Conventional Survey _____, USGS quad _____, Hand-held GPS _____, Survey-grade GPS _____				
<u>Progress</u> City	<u>MS</u> State	Zip Code	<u>SW 1/4 NE 1/4, Sec 11 T 1N R 9E</u>		
Telephone No. () _____	Miles _____ of _____		(Distance) (Direction) (Nearest Town)		

Pump Type (check one)

Submersible Turbine Air Lift Centrifugal Flowing Well Jet Piston Rotary Other (describe): _____

Date Pump Installed: 5-9-18 Rated Pump Capacity: 25 Gallons Per Minute

Is This Pump (check one): New Repaired Replacement

Power Type (check one)

Electric Diesel Gasoline Natural Gas Tractor PTO Windmill Other (describe): _____

Horse Power Rating of Motor: 1 1/2 Setting Depth: 120 feet Number of Stages: _____

Pump Test Data for Non Flowing Well

Date Well Tested: _____ Duration of Pump Test (minimum 4 hours): _____ hours

Static Water Level (A): _____ Feet Below Land Surface Pumping Water Level (B): _____ Feet Below Land Surface

Drawdown [(B) - (A)]: _____ Feet Below Land Surface Test Pumping Rate: _____ Gallons Per Minute

Method of measurement (check one): Steel tape Electric tape Air line Other (describe): _____

Pump Test Data for Flowing Well

Measured shut in head: _____ feet.

Well yielded _____ GPM with a drawdown of _____ feet after _____ hours of pumping

Meter Installation

Meter Manufacturer: _____ Meter Serial Number: _____

Meter Model Number/Name: _____ Type of Meter: _____

Totalizer Register Unit and Multiplier Factor (AF x .001, gal x 1000, etc): _____

Installation Date: _____ Meter installed by: _____

Is This Meter (check one): New Repaired Replacement


Important: By submitting the above information you are certifying that this meter was installed to manufacturer standards. For agricultural wells, a list of approved meters is on the MDEQ website.

I HEREBY CERTIFY that the above statements are true to the best of my knowledge.


Brian Fitzgerald 029 5-9-18 Brian Fitzgerald
 Print Name of Pump Installer and License No. (if applicable) Date Signature of Pump Installer

M178

Google Maps 31°04'09.7"N 90°16'01.2"W

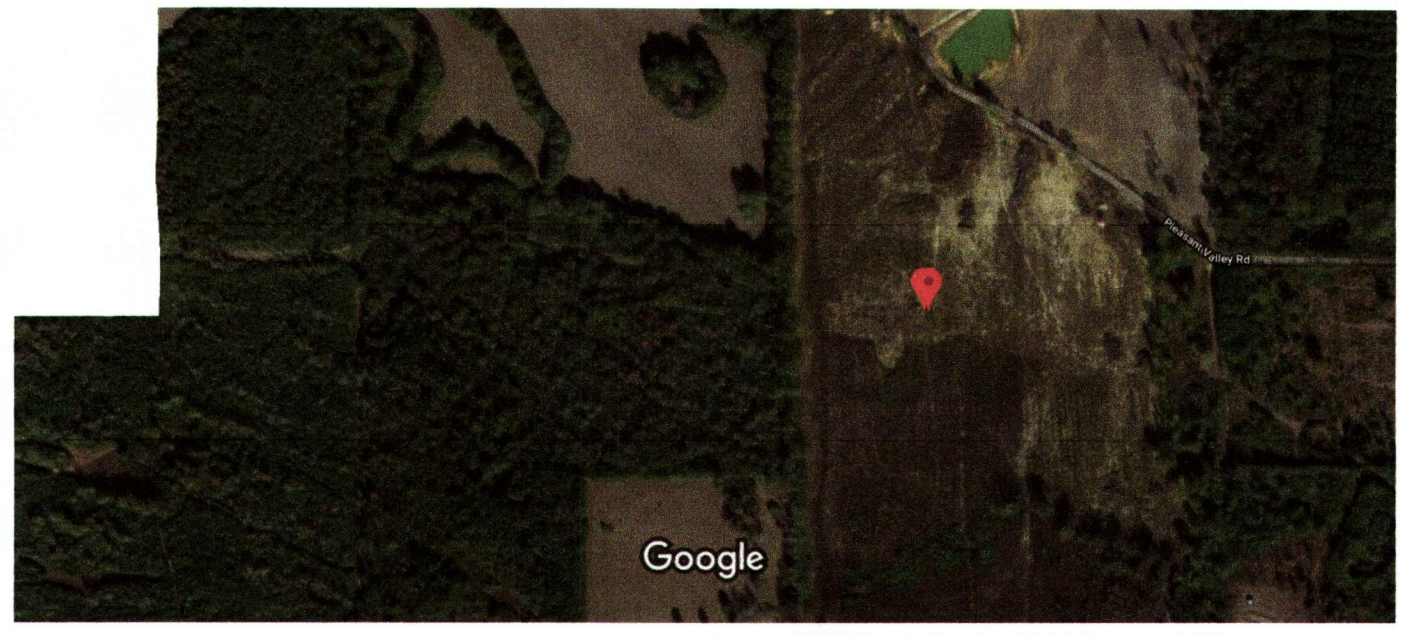

Imagery ©2018 Google, Map data ©2018 Google 200 ft

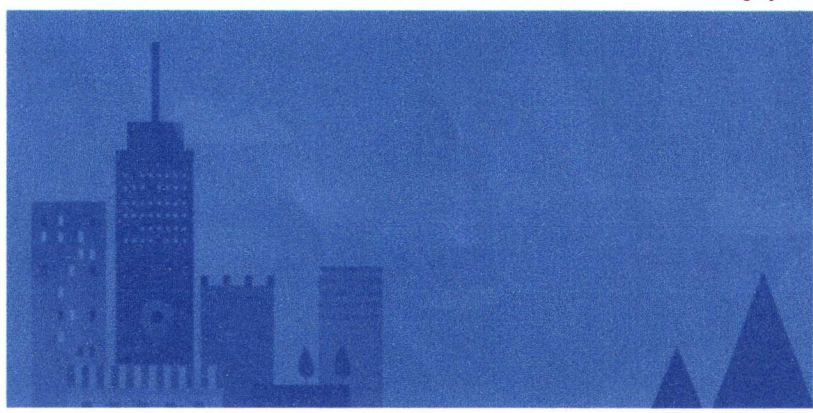

31°04'09.7"N 90°16'01.2"W

31.069351, -90.266993

3P9M+P6 Progress, Mississippi

③

Mark Harrison
Pleasant Valley Rd.

148-75-120

1 1/2 HP

5-9-18

RECEIVED
OCT 04 2018
BY OLWF