

PIKE
M 2000
1-14-76

MISSISSIPPI
BOARD OF WATER COMMISSIONERS
416 North State Street
132 Jackson, Mississippi 39201

WATER WELL DRILLERS LOG

Jan 14 1976 *Reems Wellies* *Pike*
date well completed firm name county well located

LANDOWNER:
Fay, S. Smith
At 2 - McComb
(mailing address)

description of formations encountered	from	to
<i>Red Clay</i>	<i>0</i>	<i>22</i>
<i>Red sand</i>	<i>22</i>	<i>80</i>
<i>Red Chalk</i>	<i>80</i>	<i>90</i>
<i>pebbles to sand</i>	<i>100</i>	<i>110</i>


WELL LOCATION:
sec. *20* T-*1* N R-*9* E
in miles (distance) *Progress* (direction) (nearest town)

WELL PURPOSE: *store*
(home, irrigation, municipal, industrial)

- WELL COMPLETION DATA:
- (1) diameter (inches) *4"*
 - (2) total depth (feet) *110*
 - (3) static water level (feet) *80* below top of ground.
 - (4) casing *plastic bottom*
(material) (depth)
 - (5) screen *6'* *110*
(length) (depth to top)
 - 4"* *plastic*
(size) (material)
 - (6) pump *—* *—*
(HP) (yield gpm)
 - elect*
(type power)
 - (7) electric log *no*
(yes or no)
 - (organization running log)

(8) how well bottom plugged
Wooden plug

DRILLERS REMARKS:
no remark

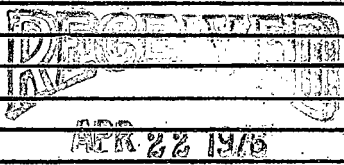

If well telescopes please sketch and show depths.

GROUND LEVEL

X			

SECTION 20

Please indicate well location X.

ADDITIONAL INFORMATION

If more than one screen, show locations of each on sketch.