

Pike
 M 2002
 4-3-76

MISSISSIPPI
 BOARD OF WATER COMMISSIONERS
 416 North State Street
 Jackson, Mississippi 39201

WATER WELL DRILLERS LOG

April 3 1976 *Recesswell Ser* *Pike*
 date well completed firm name county well located

LANDOWNER:
Mr. Jack Copeland
P.O. box 24 Tylertown
 (mailing address)

description of formations encountered	from	to
<i>Red Clay</i>	<i>0</i>	<i>20</i>
<i>Red sand clay</i>	<i>20</i>	<i>80</i>
<i>sand & gravel</i>	<i>80</i>	<i>95</i>
<i>labbk</i>	<i>95</i>	<i>118</i>
<i>peagravel</i>	<i>118</i>	<i>133</i>

WELL LOCATION:
 sec. *11* T. *1* N. R. *9* E.
3 1/2 miles *E.N.E.* of *Proctor*
 (distance) (direction) (nearest town)

WELL PURPOSE: *Trailer*
 (home, irrigation, municipal, industrial)

- WELL COMPLETION DATA:
- (1) diameter (inches) *1 1/2"*
 - (2) total depth (feet) *133*
 - (3) static water level (feet) *80* below above top of ground.
 - (4) casing *plastic bottom*
 (material) (depth)
 - If telescope see back.
 (size)
 - (5) screen *127*
 (length) (depth to top)
 - 4"* *plastic*
 (size) (material)
 - (6) pump *15hp* *10*
 (HP) (yield gpm)
 - elect.*
 (type power)
 - (7) electric log *no*
 (yes or no)
 - (organization running log)


(8) how well bottom plugged:
wooden plug

DRILLERS REMARKS:
new location

RECEIVED
 APR 8 1976

If well telescopes please sketch and show depths.

GROUND LEVEL

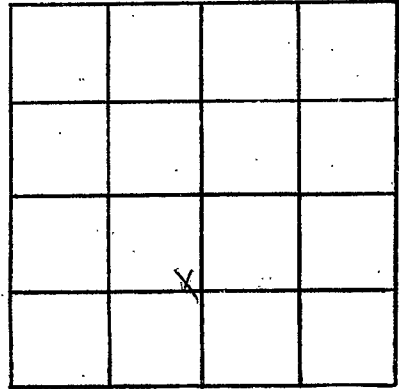

SECTION 11

Please indicate well location X.

ADDITIONAL INFORMATION

If more than one screen, show locations of each on sketch.