

Pike
 M 2003
 6/5/76

MISSISSIPPI
 BOARD OF WATER COMMISSIONERS
 416 North State Street
 Jackson, Mississippi 39201

130

WATER WELL DRILLERS LOG

June 15 1976 *News Miller* *Pike*
 date well completed firm name county well located


LANDOWNER:	description of formations encountered	from	to
<i>Mary Banks</i> <i>Rt 2, m c c sub</i> (mailing address)			
	<i>bleached sand</i>	<i>22</i>	<i>80</i>
	<i>small gravel</i>	<i>80</i>	<i>87</i>
	<i>pink cherty sand</i>	<i>87</i>	<i>105</i>
	<i>small gravel</i>	<i>105</i>	<i>120</i>
WELL LOCATION: sec. <i>11</i> T. <i>1</i> N. R. <i>9</i> E <i>3</i> miles <i>N-NE</i> of <i>Progress</i> (distance) (direction) (nearest town)			
WELL PURPOSE: <i>home</i> (home, irrigation, municipal, industrial)			
WELL COMPLETION DATA: (1) diameter (inches) <i>4"</i> (2) total depth (feet) <i>120</i> (3) static water level (feet) <i>63</i> below above top of ground. (4) casing <i>plastic bottom</i> (material) (depth) <i>6"</i> if telescope see back. (size) (5) screen <i>6'</i> <i>114'</i> (length) (depth to top) <i>4"</i> <i>plastic</i> (size) (material) (6) pump <i>sub</i> <i>1.0</i> (HP) (yield gpm) <i>elect</i> (type power) (7) electric log <i>no</i> (yes or no) (organization running log) (8) how well bottom plugged <i>wooden plug</i>			
DRILLERS REMARKS: <i>no remarks</i>			

RECEIVED
 OCT - 7 1976

MISS. BD. OF WATER COMMISSIONERS

If well telescopes please sketch and show depths.

GROUND LEVEL

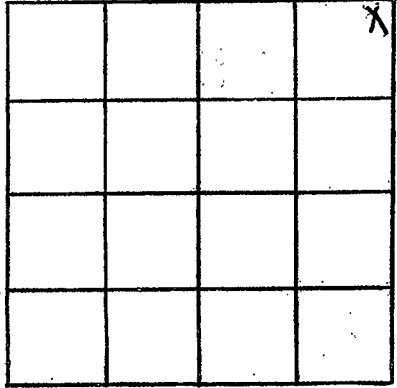

SECTION 10

Please indicate well location X.

ADDITIONAL INFORMATION

If more than one screen, show locations of each on sketch.