

**MISSISSIPPI
BOARD OF WATER COMMISSIONERS**
416 North State Street
Jackson, Mississippi 39201

WATER WELL DRILLERS LOG

Pike
M 2004
6-5-76


June 5 1976 Reynolds & Sons Pike
date well completed firm name county well located

| LANDOWNER: | description of formations encountered | from | to |
|---|---------------------------------------|------------|------------|
| <u>Mrs. Velma James</u> | | | |
| <u>Alt 2 - McComb</u> (mailing address) | <u>Red sand & gravel</u> | <u>17</u> | <u>85</u> |
| WELL LOCATION: | <u>Gravel</u> | <u>85</u> | <u>96</u> |
| sec. <u>11</u> T. <u>1</u> N. R. <u>9</u> E | <u>Chalk (pink)</u> | <u>96</u> | <u>110</u> |
| <u>4</u> miles <u>E-NE</u> of <u>Progers</u> | <u>Gravel & sand</u> | <u>110</u> | <u>192</u> |
| (distance) (direction) (nearest town) | | | |
| WELL PURPOSE: <u>home</u> (home, irrigation, municipal, industrial) | | | |
| WELL COMPLETION DATA: | | | |
| (1) diameter (inches) <u>4"</u> | | | |
| (2) total depth (feet) <u>122</u> | | | |
| (3) static water level (feet) <u>80</u> below above top of ground. | | | |
| (4) casing <u>Plastic bottom</u> (material) (depth) | | | |
| <u> </u> If telescope see back. (size) | | | |
| (5) screen <u>6"</u> <u>116</u> (length) (depth to top) | | | |
| <u>4"</u> <u>Plastic</u> (size) (material) | | | |
| (6) pump <u>1/2 Sub</u> <u>10</u> (HP) (yield gpm) | | | |
| <u>elect</u> (type power) | | | |
| (7) electric log <u>no</u> (yes or no) | | | |
| <u> </u> (organization running log) | | | |
| (8) how well bottom plugged <u>Washed plug</u> | | | |
| DRILLERS REMARKS: <u>no remark</u> | | | |

RECEIVED
OCT - 7 1976

If well telescopes please sketch and show depths.

GROUND LEVEL

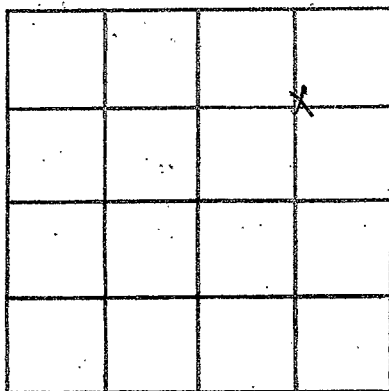

SECTION 11

Please indicate well location X.

ADDITIONAL INFORMATION

If more than one screen, show locations of each on sketch.