

Pike  
M 2000  
10/2/76

MISSISSIPPI  
 BOARD OF WATER COMMISSIONERS  
 416 North State Street  
 Jackson, Mississippi 39201

WATER WELL DRILLERS LOG

oct 2  
 date well completed

13%

76 Beechwell Sec.  
 firm name

Pike  
 county well located


LANDOWNER:	description of formations encountered	from	to
<u>O. T. Caston</u>			
<u>Rt 2 - McComb -</u> (mailing address)	<u>Red sand</u>	<u>22</u>	<u>67</u>
WELL LOCATION:	<u>medium gravel</u>	<u>67</u>	<u>75</u>
sec <u>2</u> T <u>1</u> N R <u>9</u> E	<u>Chalk - Shale (Pencil)</u>	<u>75</u>	<u>120</u>
<u>4</u> miles <u>NE</u> of <u>Progress</u>	<u>Coarse sand &amp; gravel</u>	<u>120</u>	<u>127</u>
(distance) (direction) (nearest town)			
WELL PURPOSE: <u>Home</u> (home, irrigation, municipal, industrial)			
WELL COMPLETION DATA:			
(1) diameter (inches) <u>4"</u>			
(2) total depth (feet) <u>127</u>			
(3) static water level (feet) <u>78</u> below top of ground.			
(4) casing <u>plastic</u> bottom (material) (depth)			
(size) If telescope see back.			
(5) screen <u>6"</u> <u>121</u> (length) (depth to top)			
<u>4"</u> <u>plastic</u> (size) (material)			
(6) pump <u>1/2</u> <u>10</u> (HP) (yield gpm)			
<u>skt</u> (type power)			
(7) electric log <u>no</u> (yes or no)			
(organization running log)			
(8) how well bottom plugged <u>wooden plug</u>			
DRILLERS REMARKS:			

RECEIVED

FEB - 4 1977

If well telescopes please sketch and show depths.

GROUND LEVEL

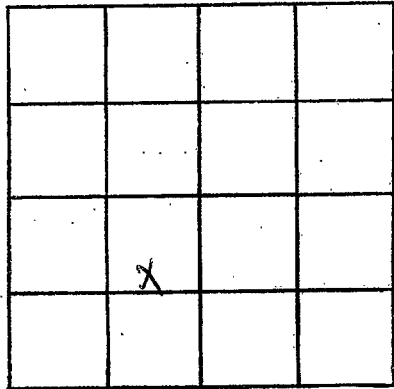

SECTION 2

Please indicate well location X.

ADDITIONAL INFORMATION

If more than one screen, show locations of each on sketch.