

Pike
 M 2010
 8/18/77

MISSISSIPPI
 BOARD OF WATER COMMISSIONERS
 416 North State Street
 Jackson, Mississippi 39201

108

WATER WELL DRILLERS LOG

Aug 18 1977 Beumiller Pike
 date well completed firm name county well located

LANDOWNER:
Arthur Magill
Rt 3 Magnolia
 (mailing address)

WELL LOCATION:
 sec. 6 T. 1 N R. 9 E
9 miles E-SE of Magnolia
 (distance) (direction) (nearest town)

WELL PURPOSE: home
 (home, irrigation, municipal, industrial)

WELL COMPLETION DATA:
 (1) diameter (inches) _____
 (2) total depth (feet) 133
 (3) static water level (feet) 100 below top of ground.
 (4) casing plastic bottom (material) (depth)
 _____ if telescope see back. (size)
 (5) screen 6' 127 (length) (depth to top)
4" plastic (size) (material)
 (6) pump 1/2 hp 10 (HP) (field gpm)
elect (type power)
 (7) electric log no (yes or no)
 _____ (organization running log)

(8) how well bottom plugged
wooden plug
 DRILLERS REMARKS:


description of formations encountered	from	to
<u>clay</u>	<u>0</u>	<u>20</u>
<u>cherty sand</u>	<u>20</u>	<u>60</u>
<u>sandy ground</u>	<u>60</u>	<u>95</u>
<u>cherty sand</u>	<u>95</u>	<u>115</u>
<u>perforated sand</u>	<u>115</u>	<u>133</u>

RECEIVED
 DEC 30 1977

MISS. BD. OF WATER COMM

If well telescopes please sketch and show depths.

GROUND LEVEL

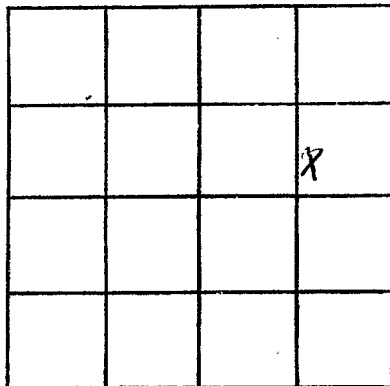

SECTION 12

Please indicate well location X.

ADDITIONAL INFORMATION

If more than one screen,
show locations of each on sketch.