

PIKE
M 2012
5-24-78

MISSISSIPPI
BOARD OF WATER COMMISSIONERS
416 North State Street
Jackson, Mississippi 39201

WATER WELL DRILLERS LOG

5-24 19 78 Fitzgerald Well Serv Pike
date well completed firm name county well located

LANDOWNER:	description of formations encountered	from	to
<u>J. B. Howell</u> <u>R.R. Magnolia</u> (mailing address)			
	<u>Red sand & gravel</u>	<u>20</u>	<u>120</u>
	<u>Coarse sand & gravel</u>	<u>120</u>	<u>148</u>

WELL LOCATION:
sec. 15 T 1 N R 9 E
S W
3 miles NE of Progress
(distance) (direction) (nearest town)

WELL PURPOSE:
Home
(home, irrigation, municipal, industrial)

WELL COMPLETION DATA:

(1) diameter (inches) 4

(2) total depth (feet) 148

(3) static water level (feet) 100 below above top of ground.

(4) casing PVC, 140,
(material) (depth)
4 if telescope see back.
(size)

(5) screen 8, 140
(length) (depth to top)
4, PVC
(size) (material)

(6) pump 1/2, 10
(HP) (yield gpm)
Elc
(type power)

(7) electric log no
(yes or no)
(organization running log)


(8) how well bottom plugged Sand fill

JUN 23 1978
MISS. BD. OF WATER COMMISSIONERS

DRILLERS REMARKS:

If well telescopes please sketch and show depths.

GROUND LEVEL

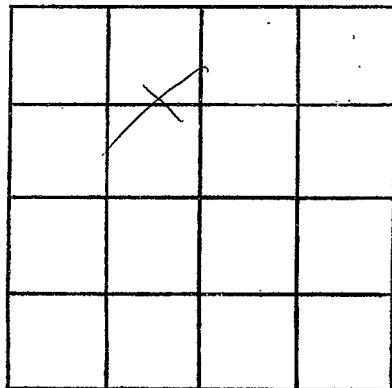

SECTION 15

Please indicate well location X.

ADDITIONAL INFORMATION

If more than one screen,
show locations of each on sketch.