

PIKE
M 2013
1/78

MISSISSIPPI
BOARD OF WATER COMMISSIONERS
416 North State Street
Jackson, Mississippi 39201

WATER WELL DRILLERS LOG

1- date well completed 1979 Red Mountain Water Well Service firm name Pike Co county well located

LANDOWNER: *Mr. Michael Fortenberry*
Osyka Rt 1 Box 4681
Miss 39647
(mailing address)

WELL LOCATION:
sec. *27* T11 N R *09* E W
6 miles East of *Osyka*
(distance) (direction) (nearest town)

WELL PURPOSE:
(home, irrigation, municipal, industrial)

WELL COMPLETION DATA:

(1) diameter (inches) 4

(2) total depth (feet) 145

(3) static water level (feet) 80 below above top of ground.

(4) casing PVC (material), 145' (depth),
(size) if telescope see back.

(5) screen PVC - 10' (length), 135 (depth to top)
.012 (size), PVC (material)

(6) pump 1/2 (HP), 8 (yield gpm)
220 volt AC (type power)

(7) electric log (yes or no)
(organization running log)

(8) how well bottom plugged 2"
sand screen

description of formations encountered	from	to
<i>top clay</i>	<i>0</i>	<i>20</i>
<i>Dry sand</i>	<i>20</i>	<i>40</i>
<i>Clay Gravel</i>	<i>40</i>	<i>60</i>
<i>Fine Sand</i>	<i>60</i>	<i>80</i>
<i>Chalk & Gravel</i>	<i>80</i>	<i>120</i>
<i>water Bearing Sand</i>	<i>120</i>	<i>145</i>

RECEIVED


JAN 27 1979

MISS. BLD. OF WATER COMMISSIONERS

DRILLERS REMARKS:

If well telescopes please sketch and show depths.

GROUND LEVEL

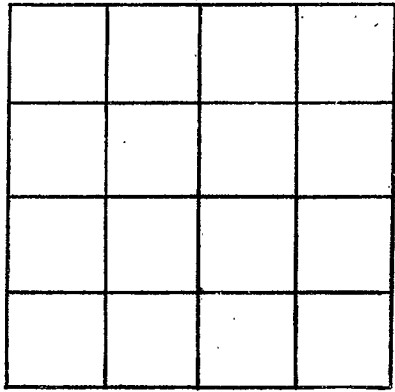

SECTION _____

Please indicate well location X.

ADDITIONAL INFORMATION

A series of horizontal lines providing space for additional information.

If more than one screen, show locations of each on sketch.