

PIKE
 M 2014
 3.15-78

MISSISSIPPI
 BOARD OF WATER COMMISSIONERS
 416 North State Street
 Jackson, Mississippi 39201

WATER WELL DRILLERS LOG

March 15 1978 Reeves Well Co. Pipe
 date well completed firm name county well located

LANDOWNER:	description of formations encountered	from	to
John Hall III Rt 2 McComb - (mailing address)	clay red sand mixed gravel sand coarse sand pea gravel	0 17 65 103	17 65 103 118
WELL LOCATION: sec 2 T 1 N R 9 E 4 miles N-NE of Poplar (distance) (direction) (nearest town)			
WELL PURPOSE: house (home, irrigation, municipal, industrial)			
WELL COMPLETION DATA:			
(1) diameter (inches) 4"			
(2) total depth (feet) 118			
(3) static water level (feet) 70 below top of ground.			
(4) casing plastic bottom (material) (depth)			
if telescope see back.			
(5) screen 5' 113 (length) (depth to top)			
4" plastic (size) (material)			
(6) pump by Albers (HP) (yield gpm)			
elect (type power)			
(7) electric log no (yes or no)			
(organization running log)			
(8) how well bottom plugged wooden plug			
DRILLERS REMARKS:			


RECEIVED

JUN - 8 1978

MISS. BD. OF WATER COMM

If well telescopes please sketch and show depths.

GROUND LEVEL

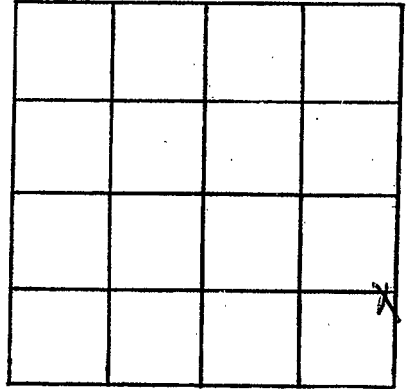

SECTION 2

Please indicate well location X.

ADDITIONAL INFORMATION

If more than one screen,
show locations of each on sketch.