

PIKE

2015 M.

6-22-78

**MISSISSIPPI
BOARD OF WATER COMMISSIONERS
416 North State Street
Jackson, Mississippi 39201**

WATER WELL DRILLERS LOG

June 22 1978 date well completed

Reeves Well firm name

Pike county well located

LANDOWNER:

*Keith Brock -
Rt 2 Myrtle Creek -
(mailing address)*

description of formations encountered**from****to**

<i>Red clay</i>	0	20
<i>Mis. Limestone</i>	20	60
<i>Sand & Gravel</i>	60	80
<i>Hard Sand Rock</i>	80	81
<i>Brown sand</i>	81	100
<i>Hard sand Rock</i>	100	102
<i>Fine sand</i>	102	115
<i>Bend ground</i>	115	142

WELL LOCATION:

sec. 11 T. 1 N. R. 9 E.

4 miles E SITE (distance) of (direction) (nearest town)

WELL PURPOSE: *Tourist*
(home, irrigation, municipal, industrial)**WELL COMPLETION DATA:**

- (1) diameter (inches) 4"
 (2) total depth (feet) 149'
 (3) static water level (feet) 81 below top of ground.
 (4) casing plastic, bottom (material) (depth)

 if telescope see back.
(size)

- (5) screen 10', 132'
(length) (depth to top)
4", plastic
(size) (material)

- (6) pump 1/2 HP, 25
(HP) (yield gpm)

elect
(type power)

- (7) electric log no
(yes or no)

(organization running log)

- (8) how well bottom plugged
Wooden plug


DRILLERS REMARKS:*bad sand rocks***RECEIVED**

OCT 25 1978

MISS. BD. OF WATER COMM.

If well telescopes please
sketch and show depths.

GROUND LEVEL

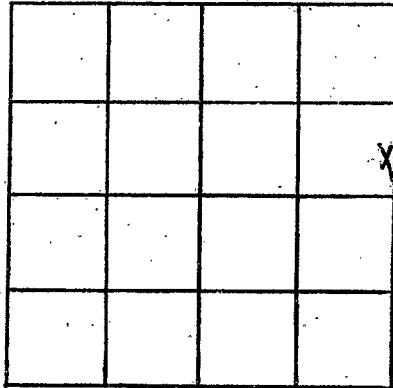

SECTION 

Please indicate well location X.

ADDITIONAL INFORMATION

If more than one screen,
show locations of each on sketch.