

PIKE
M 2016
6-7-78

MISSISSIPPI
BOARD OF WATER COMMISSIONERS
416 North State Street
Jackson, Mississippi 39201

WATER WELL DRILLERS LOG

June 7 1978 Acme Well Co Pike
 date well completed firm name county well located

LANDOWNER:	description of formations encountered	from	to
<u>Mr. Jack Copland</u>			
<u>Rt 2. McComb</u> (mailing address)	<u>Red Clay</u>	<u>0</u>	<u>5</u>
	<u>Red Clay & Gravel</u>	<u>5</u>	<u>40</u>
	<u>Sand Gravel</u>	<u>40</u>	<u>70</u>
	<u>Chalk</u>	<u>70</u>	<u>83</u>
	<u>Blocky sand & gravel</u>	<u>83</u>	<u>105</u>
	<u>Coars sand & gravel</u>	<u>105</u>	<u>134</u>
	<u>Red Gravel</u>		

WELL LOCATION:
 sec 23 T 1 N R 9 E
4 miles ESE of Progress
 (distance) (direction) (nearest town)

WELL PURPOSE: Log Farm
 (home, irrigation, municipal, industrial)

WELL COMPLETION DATA:

(1) diameter (inches) 4"

(2) total depth (feet) 134'

(3) static water level (feet) 70 below
 top of ground above

(4) casing plastic bottom
 (material) (depth)
 (size) if telescope see back.


(5) screen 10' 126
 (length) (depth to top)
4" plastic
 (size) (material)

(6) pump 2 1/2 30
 (HP) (yield gpm)
elect
 (type power)

(7) electric log no
 (yes or no)
 (organization running log)

(8) how well bottom plugged wood plug


DRILLERS REMARKS:

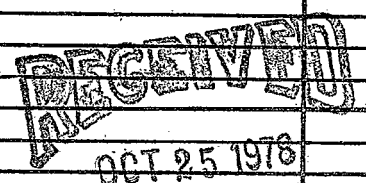

MISS. BD. OF WATER COMMISSIONERS

If well telescopes please sketch and show depths.

GROUND LEVEL

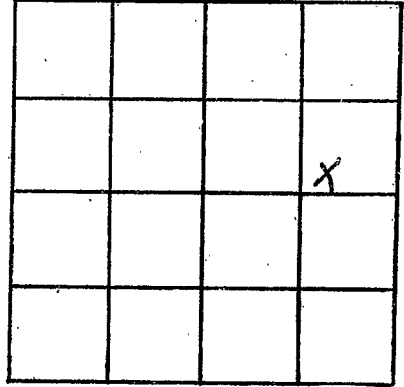

SECTION 23

Please indicate well location X.

ADDITIONAL INFORMATION

If more than one screen,
show locations of each on sketch.