

PIKE

M 207

9-12-78

MISSISSIPPI
 BOARD OF WATER COMMISSIONERS
 416 North State Street
 Jackson, Mississippi 39201

WATER WELL DRILLERS LOG

9-12-78
date well completed

St. Andrew's
firm name

Pike
county well located


LANDOWNER:	description of formations encountered	from	to
<i>J. A. Magee</i>	<i>Red clay</i>	0	20
<i>R.R. Magnolia</i> (mailing address)	<i>Red sand</i>	20	100
WELL LOCATION:	<i>Coarse sand & gravel</i>	100	115
sec. <i>6</i> T <i>1</i> N R <i>9</i> E S W			
<i>10</i> miles <i>E</i> of <i>Magnolia</i> (distance) (direction) (nearest town)			
WELL PURPOSE: <i>Home</i> (home, irrigation, municipal, industrial)			
WELL COMPLETION DATA:			
(1) diameter (inches) <i>4</i>			
(2) total depth (feet) <i>115</i>			
(3) static water level (feet) <i>92</i> below top of ground.			
(4) casing <i>PVC 107</i> (material) (depth)			
<i>4</i> if telescope see back. (size)			
(5) screen <i>8</i> <i>107</i> (length) (depth to top)			
<i>4</i> <i>PVC</i> (size) (material)			
(6) pump <i>1/2</i> <i>10</i> (HP) (yield gpm)			
<i>Electric</i> (type power)			
(7) electric log <i>no</i> (yes or no)			
(organization running log)			
(8) how well bottom plugged <i>Sand thick</i>			
DRILLERS REMARKS:			

RECEIVED
 OCT 1 1978

MISS. BD. OF WATER COM.

If well telescopes please sketch and show depths.

GROUND LEVEL

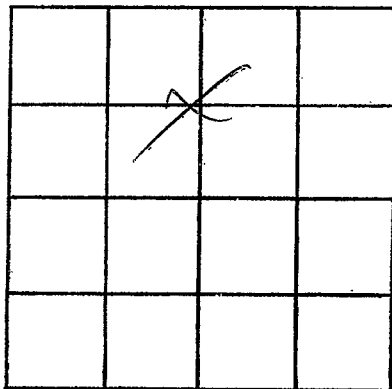

SECTION 6

Please indicate well location X.

ADDITIONAL INFORMATION

If more than one screen,
show locations of each on sketch.