

PIKE
M 208
11-10-78

**MISSISSIPPI
BOARD OF WATER COMMISSIONERS**
416 North State Street
Jackson, Mississippi 39201

WATER WELL DRILLERS LOG

11-10 1978 *Fitzgerald* *Pike*
 date well completed firm name county well located


LANDOWNER:	description of formations encountered	from	to
<i>Joe Brown</i> <i>Progers, ms -</i> (mailing address)	<i>Red Clay</i>	0	20
WELL LOCATION:	<i>Red gravel</i>	20	108
sec. <u>17</u> T <u>1</u> N R <u>9</u> S W miles <u>1.14</u> of <i>Progers</i> (distance) (direction) (nearest town)	<i>Red sand</i>	108	115
WELL PURPOSE: <i>Home</i> (home, irrigation, municipal, industrial)	<i>Green sand</i>	115	134
WELL COMPLETION DATA:			
(1) diameter (inches) <u>4</u>			
(2) total depth (feet) <u>134</u>			
(3) static water level (feet) <u>85</u> below top of ground.			
(4) casing <u>PVC, 126</u> (material) (depth) <u>4</u> if telescope see back. (size)			
(5) screen <u>8, 126</u> (length) (depth to top) <u>4</u> , <u>PVC</u> (size) (material)			
(6) pump <u>1/2</u> <u>10</u> (HP) (yield gpm) <u>che</u> (type power)			
(7) electric log <u>che</u> (yes or no) (organization running log)			
(8) how well bottom plugged <u>sand thick</u>			
DRILLERS REMARKS:			

RECEIVED
DEC - 7 1978

MISS. BD. OF WATER COMMISSIONERS

If well telescopes please sketch and show depths.

GROUND LEVEL

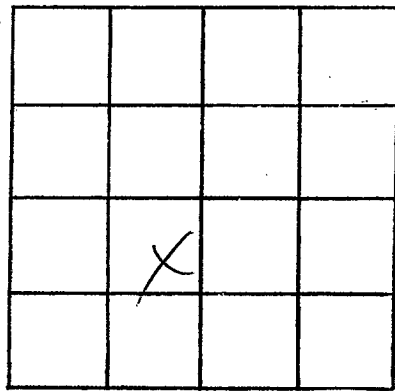

SECTION 17

Please indicate well location X.

ADDITIONAL INFORMATION

Lined area for additional information.

If more than one screen, show locations of each on sketch.