

Pike
M 2021
2-28-79

MISSISSIPPI
 BOARD OF WATER COMMISSIONERS
 416 North State Street
 Jackson, Mississippi 39201

WATER WELL DRILLERS LOG

2-28 19 79 Fitzwell well serv Pike
 date well completed firm name county well located

LANDOWNER:
Bobby Primes
R.R. Macedonia ms
 (mailing address)

description of formations encountered	from	to
	<u>Red clay</u>	<u>0</u>
<u>Red sand</u>	<u>20</u>	<u>100</u>
<u>Coarse sand & gravel</u>	<u>100</u>	<u>125</u>

WELL LOCATION:
 sec. 7 T. 40 N. R. 9 E
2 miles E of EMERALD
 (distance) (direction) (nearest town)

WELL PURPOSE:
Home
 (home, irrigation, municipal, industrial)


- WELL COMPLETION DATA:
- (1) diameter (inches) 4
 - (2) total depth (feet) 125
 - (3) static water level (feet) 75 below above top of ground.
 - (4) casing PVC, 117,
 (material) (depth)
4 if telescope see back.
 (size)
 - (5) screen 8, 117
 (length) (depth to top)
4, PVC
 (size) (material)
 - (6) pump 3/4, 15
 (HP) (yield gpm)
elec
 (type power)
 - (7) electric log no
 (yes-or-no)
 - (8) how well bottom plugged Sound thick
 (organization running log)

DRILLERS REMARKS:

Miss. Board of Water Comm.
 MAR 28 1979
 RECEIVED

If well telescopes please sketch and show depths.

GROUND LEVEL

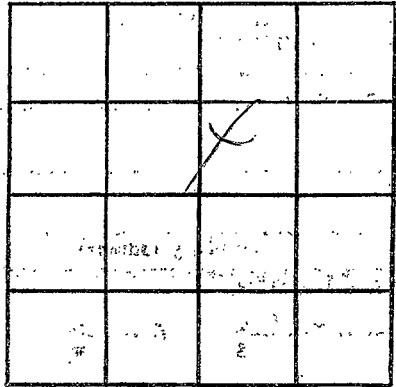

SECTION 9

Please indicate well location X.

ADDITIONAL INFORMATION

If more than one screen,
show locations of each on sketch.