

PIKE

M

6-27-79

MISSISSIPPI BOARD OF WATER COMMISSIONERS. 416 North State Street Jackson, Mississippi 39201 WATER WELL DRILLERS LOG

12

6-27 date well completed

1979 Filzsch firm name

Pike county well located

LANDOWNER:

Prentiss Solitings

R.R. Magnolia (mailing address)

description of formations encountered

from

to

Red Clay 0 20
Red sand & gravel 20 100
Coarse sand & gravel 100 115

WELL LOCATION:

sec 17 T 1 N R 9 E S W 2 miles E of Prentiss (distance) (direction) (nearest town)

WELL PURPOSE:

(home, irrigation, municipal, industrial)

WELL COMPLETION DATA:

- (1) diameter (inches) 4
(2) total depth (feet) 115
(3) static water level (feet) 50 below top of ground.
(4) casing PVC, 107 (material), (depth) 4 (size) If telescope see back.
(5) screen 8 (length), 107 (depth to top) 4 (size), PVC (material)
(6) pump 1/2 (HP), 10 (yield gpm)
(7) electric log yes (yes or no)
(organization running log)

(8) how well bottom plugged sand shell

DRILLERS REMARKS:


Miss. Board of Water Comm.

AUG 3 1979

RECEIVED

If well telescopes please sketch and show depths.

GROUND LEVEL

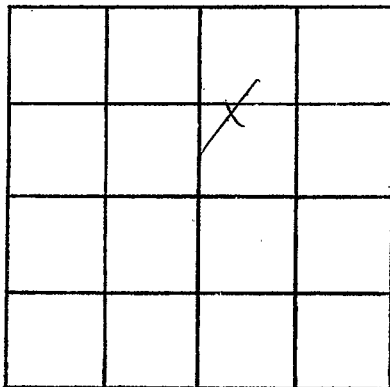

SECTION 17

Please indicate well location X.

ADDITIONAL INFORMATION

If more than one screen, show locations of each on sketch.