

Pike
M

MISSISSIPPI
BOARD OF WATER COMMISSIONERS
416 North State Street
Jackson, Mississippi 39201

2025
5-17-79

WATER WELL DRILLERS LOG

May-17 1979
date well completed

1979 Reems Miller
firm name

Pike
county well located

LANDOWNER:
Glen McKenzie
2505 Lyppard St
Ocean Springs, Ms.
(mailing address)

description of formations encountered	from	to
Red sandy clay	0	26
Red sand	26	84
lobble sand	84	105
small gravel sand	105	122

WELL LOCATION:
sec. 5 T-1 N R-9 E
9 miles S-SE of Magnolia
(distance) (direction) (nearest town)

WELL PURPOSE: home
(home, irrigation, municipal, industrial)

WELL COMPLETION DATA:
(1) diameter (inches) 4"
(2) total depth (feet) 122'
(3) static water level (feet) 82' below top of ground.
(4) casing plastic bottom
(material) (depth)
✓ If telescope see back.
(size)
(5) screen 5' 117'
(length) (depth to top)
4" plastic
(size) (material)
(6) pump 1/2 sub 10
(HP) (yield gpm)
elect
(type power)
(7) electric log no
(yes or no)
(organization running log)

(8) how well bottom plugged:
no sand plug

DRILLERS REMARKS:
✓


DEPT. OF NATURAL RESOURCES
BUREAU OF LAND & WATER RESOURCES

NOV 19 1979

RECEIVED

If well telescopes please sketch and show depths.

GROUND LEVEL

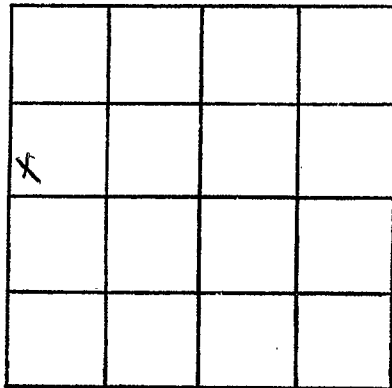

SECTION 5

Please indicate well location X.

ADDITIONAL INFORMATION

If more than one screen,
show locations of each on sketch.