

Pike  
M  
2026  
10-29-79

MISSISSIPPI  
BOARD OF WATER COMMISSIONERS  
416 North State Street  
Jackson, Mississippi 39201

WATER WELL DRILLERS LOG

10-29 1979  
date well completed

Fitzgerald Well Co  
firm name

Pike  
county well located

LANDOWNER:	description of formations encountered	from	to
Edward Magee	Red Clay	0	20
R.R. Osyko (mailing address)	Red sandstone blue sandstone	20	110 120
<b>WELL LOCATION:</b>			
sec. 18 T 1 N R 9 E 2 miles NW of Progress (distance) (direction) (nearest town)			
<b>WELL PURPOSE:</b> Home (home, irrigation, municipal, industrial)			
<b>WELL COMPLETION DATA:</b>			
(1) diameter (inches) 4			
(2) total depth (feet) 120			
(3) static water level (feet) 85 below top of ground.			
(4) casing PVC, 112, (material) (depth) 4 (size) if telescope see back.			
(5) screen 8, 112 (length) (depth to top) 4 (size) PVC (material)			
(6) pump 1/2 HP, 10 (yield gpm) Elev (type power)			
(7) electric log no (yes or no) (organization running log)			
(8) how well bottom plugged Said to be			
<b>DRILLERS REMARKS:</b>			


DEPT. OF NATURAL RESOURCES  
BUREAU OF LAND & WATER RESOURCES

NOV - 7 1979

RECEIVED

If well telescopes please sketch and show depths.

GROUND LEVEL

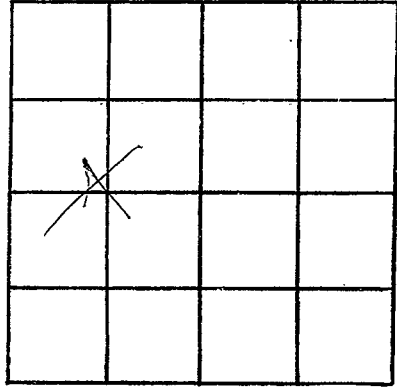

SECTION 18

Please indicate well location X.

ADDITIONAL INFORMATION

If more than one screen, show locations of each on sketch.