

BOARD OF WATER COMMISSIONERS
416 North State Street
Jackson, Mississippi 39201

PIKE
M 2027
8-10-79
Aug-10
date/well completed

WATER WELL DRILLERS LOG

179 Reussmiller Pike
firm name county well located

LANDOWNER:
Mrs. Virginia Fortaburg
(mailing address)

description of formations encountered	from	to
Clay	0	7
Red sand	7	33
Gravel & sand	55	75
pink chert	75	80
sand & gravel	80	94

WELL LOCATION:
sec 22 T 1 N R 9 E
3 miles S-SE of Progress
(distance) (direction) (nearest town)

WELL PURPOSE: home
(home, irrigation, municipal, industrial)

- WELL COMPLETION DATA:
- (1) diameter (inches) 4"
 - (2) total depth (feet) 94'
 - (3) static water level (feet) 69' below top of ground.
 - (4) casing plastic to 60' (material) (depth)
 - (5) screen 5' 89' (length) (depth to top)
 - (6) pump 4" 10 (size) (material) (HP) (yield gpm)
 - (7) electric (type power)
 - (8) electric log NO (yes or no)
- (organization running log)

DEPT. OF NATURAL RESOURCES
BUREAU OF LAND & WATER RESOURCES


MAY 20 1980

RECEIVED

(8) how well bottom plugged
wooden plug
DRILLERS REMARKS:

If well telescopes please sketch and show depths.

GROUND LEVEL

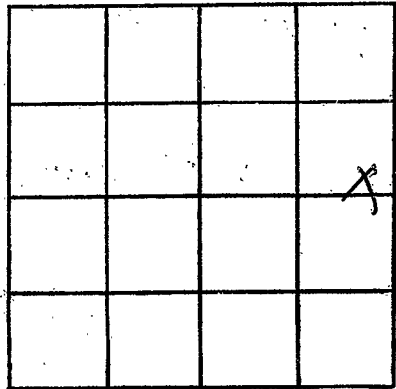

SECTION 22

Please indicate well location X.

ADDITIONAL INFORMATION

If more than one screen,
show locations of each on sketch.