

Bureau of Land and Water Resources

Southport Mall

P.O. Box 10631

Jackson, Mississippi 39209

WATER WELL DRILLERS LOG

PEKE  
M 2028  
10-6-80

Oct 6 1980  
date well completed

Acme Well Co  
firm name

Pike  
county well located


LANDOWNER:  
Hollis Alford  
Rt 2 M<sup>6</sup> Lumb  
(mailing address)

description of formations encountered	from	to
<u>Clay</u>	<u>0</u>	<u>16</u>
<u>red sand</u>	<u>16</u>	<u>70</u>
<u>pink chert</u>	<u>70</u>	<u>90</u>
<u>labbly</u>	<u>90</u>	<u>108</u>
<u>pl. gravel &amp; sand</u>	<u>108</u>	<u>119</u>

WELL LOCATION:  
sec. 17 T 1 N R 9 E  
1/2 miles east of Progress  
(distance) (direction) (nearest town)

WELL PURPOSE: Trailer  
(home, irrigation, municipal, industrial)

- WELL COMPLETION DATA:
- (1) diameter (inches) 4"
  - (2) total depth (feet) 119
  - (3) static water level (feet) 90 below top of ground.
  - (4) casing plastic bottom  
(material) (depth)
  - 1 if telescope see back.  
(size)
  - (5) screen 5' 114'  
(length) (depth to top)
  - 4" plastic  
(size) (material)
  - (6) pump 1/2 HP attorn  
(HP) (yield gpm)
  - shot  
(type power)
  - (7) electric log no  
(yes or no)

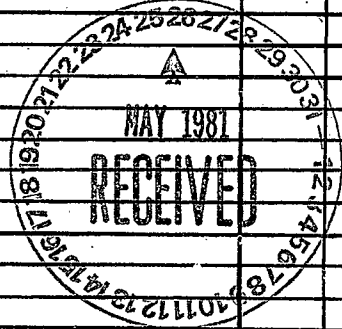


(organization running log)

(8) how well bottom plugged backwash

DRILLERS REMARKS:

If well telescopes please sketch and show depths.

GROUND LEVEL

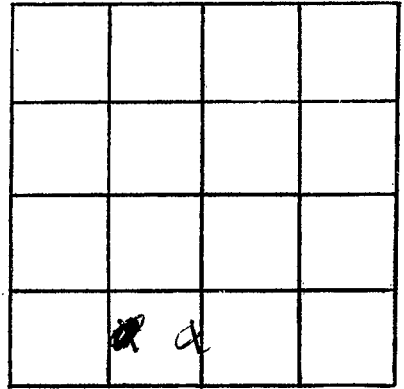

SECTION 17

Please indicate well location X.

ADDITIONAL INFORMATION

If more than one screen,  
show locations of each on sketch.